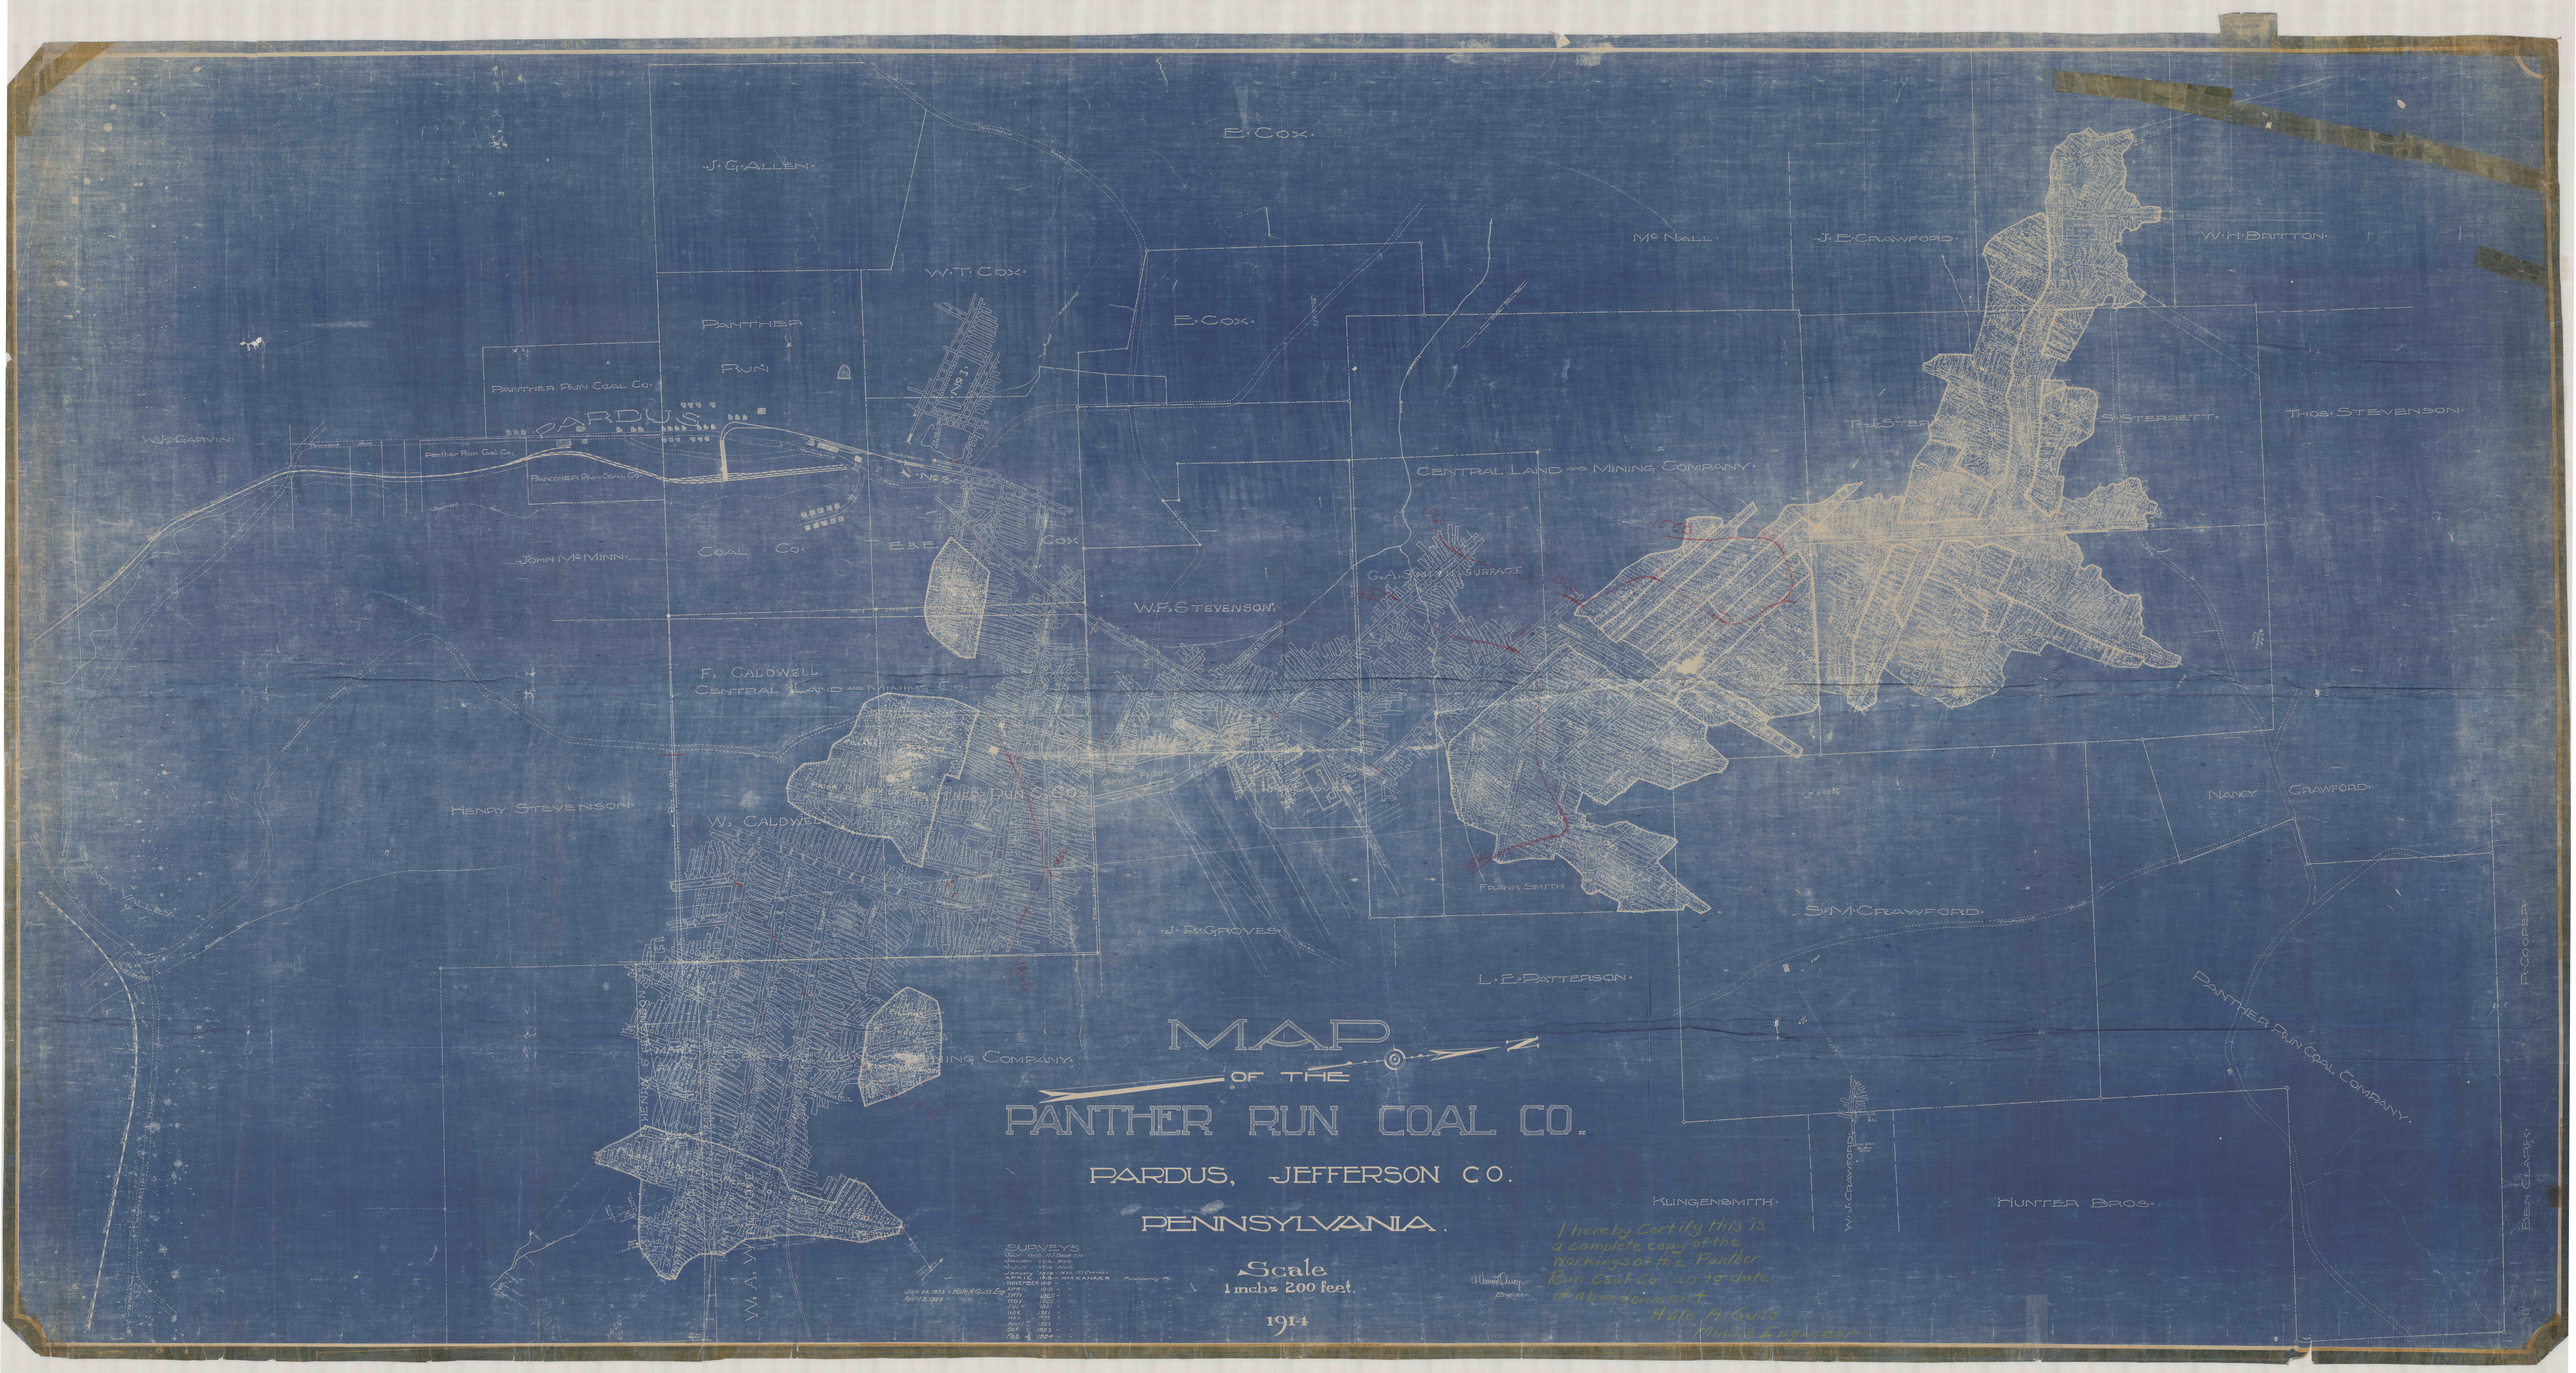

E. COX
J. G. ALLEN
W. T. COX
PANTHER RUN
E. COX
PANTHER RUN COAL CO.
PARDUS
W. S. GARVIN
Panther Run Coal Co.
Panther Run Coal Co.
No. 1
No. 2
JOHN McMINN
COAL CO.
E. & P.
COX
W. F. STEVENSON
McNALL
J. E. CRAWFORD
W. H. BRITTON
T. J. STEP
S. STERRETT
THOS. STEVENSON
CENTRAL LAND AND MINING COMPANY
G. A. SMITH SURFACE
F. CALDWELL
CENTRAL LAND AND MINING CO.
HENRY STEVENSON
W. CALDWELL
FRANK SMITH
NANCY CRAWFORD
S. M. CRAWFORD
J. F. GROVES
L. F. PATTERSON
MINING COMPANY
PANTHER RUN COAL COMPANY
R. COOPER
BEN CLARK
KLINGENSMITH
W. J. CRAWFORD
HUNTER BROS.
W. A. W.
TOWNSHIP ROAD
N
SURVEYS
Jan. 24, 1925
April 8, 1925
S40°48'E 719.3
Engineer.

MAP OF THE PANTHER RUN COAL CO.

PARDUS, JEFFERSON CO.

PENNSYLVANIA.

Scale
1 inch = 200 feet.

1914

I hereby Certify this is
a complete copy of the
Workings of the Panther
Run Coal Co., up to date
of abandonment
Hale A. Guss
Mining Engineer