

COKE CO.

H. C. FRICK


H. C.

COKE CO.

H. C.

FRICK

COKE CO.

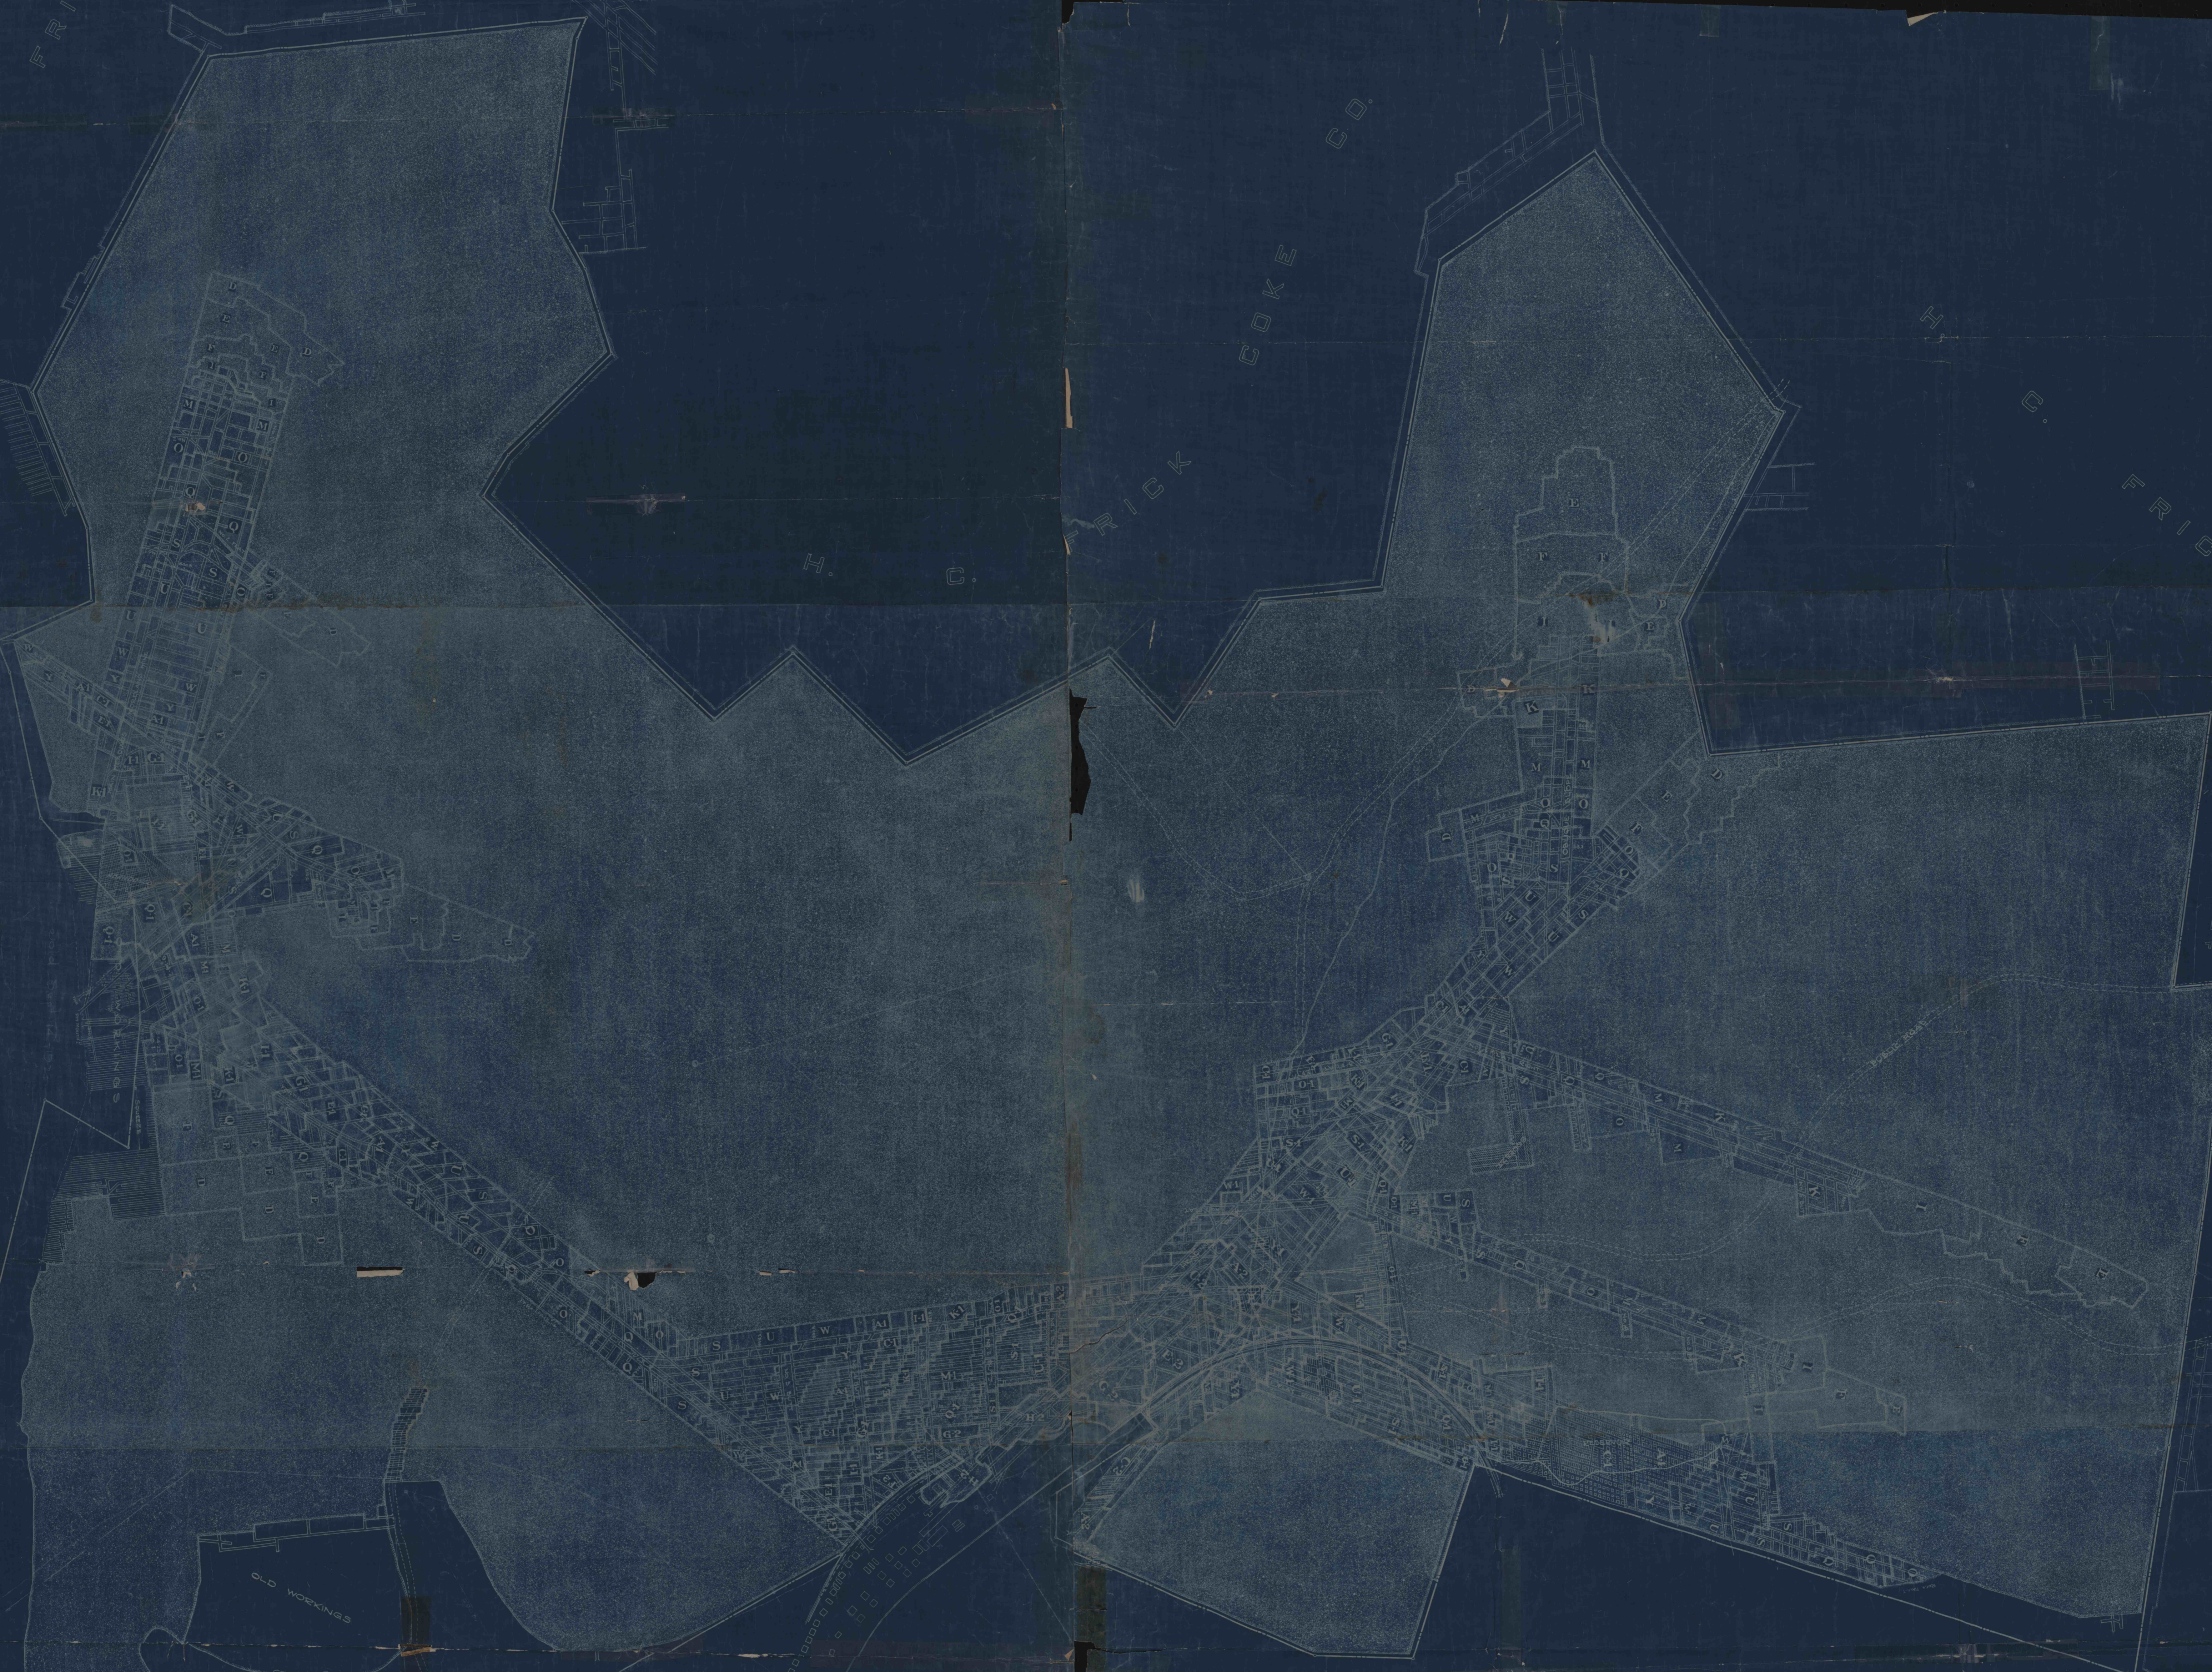

MAP OF
 MORELAND, HILL & PAUL MINES

BELONGING

W. J. RINEY

DUNBAR TOWNSHIP WYETTE CO., PA.

SCALE - 1 IN. = 100 FT.

DATE OF SURVEY

A	1-1	1-1	1-1	1-1
