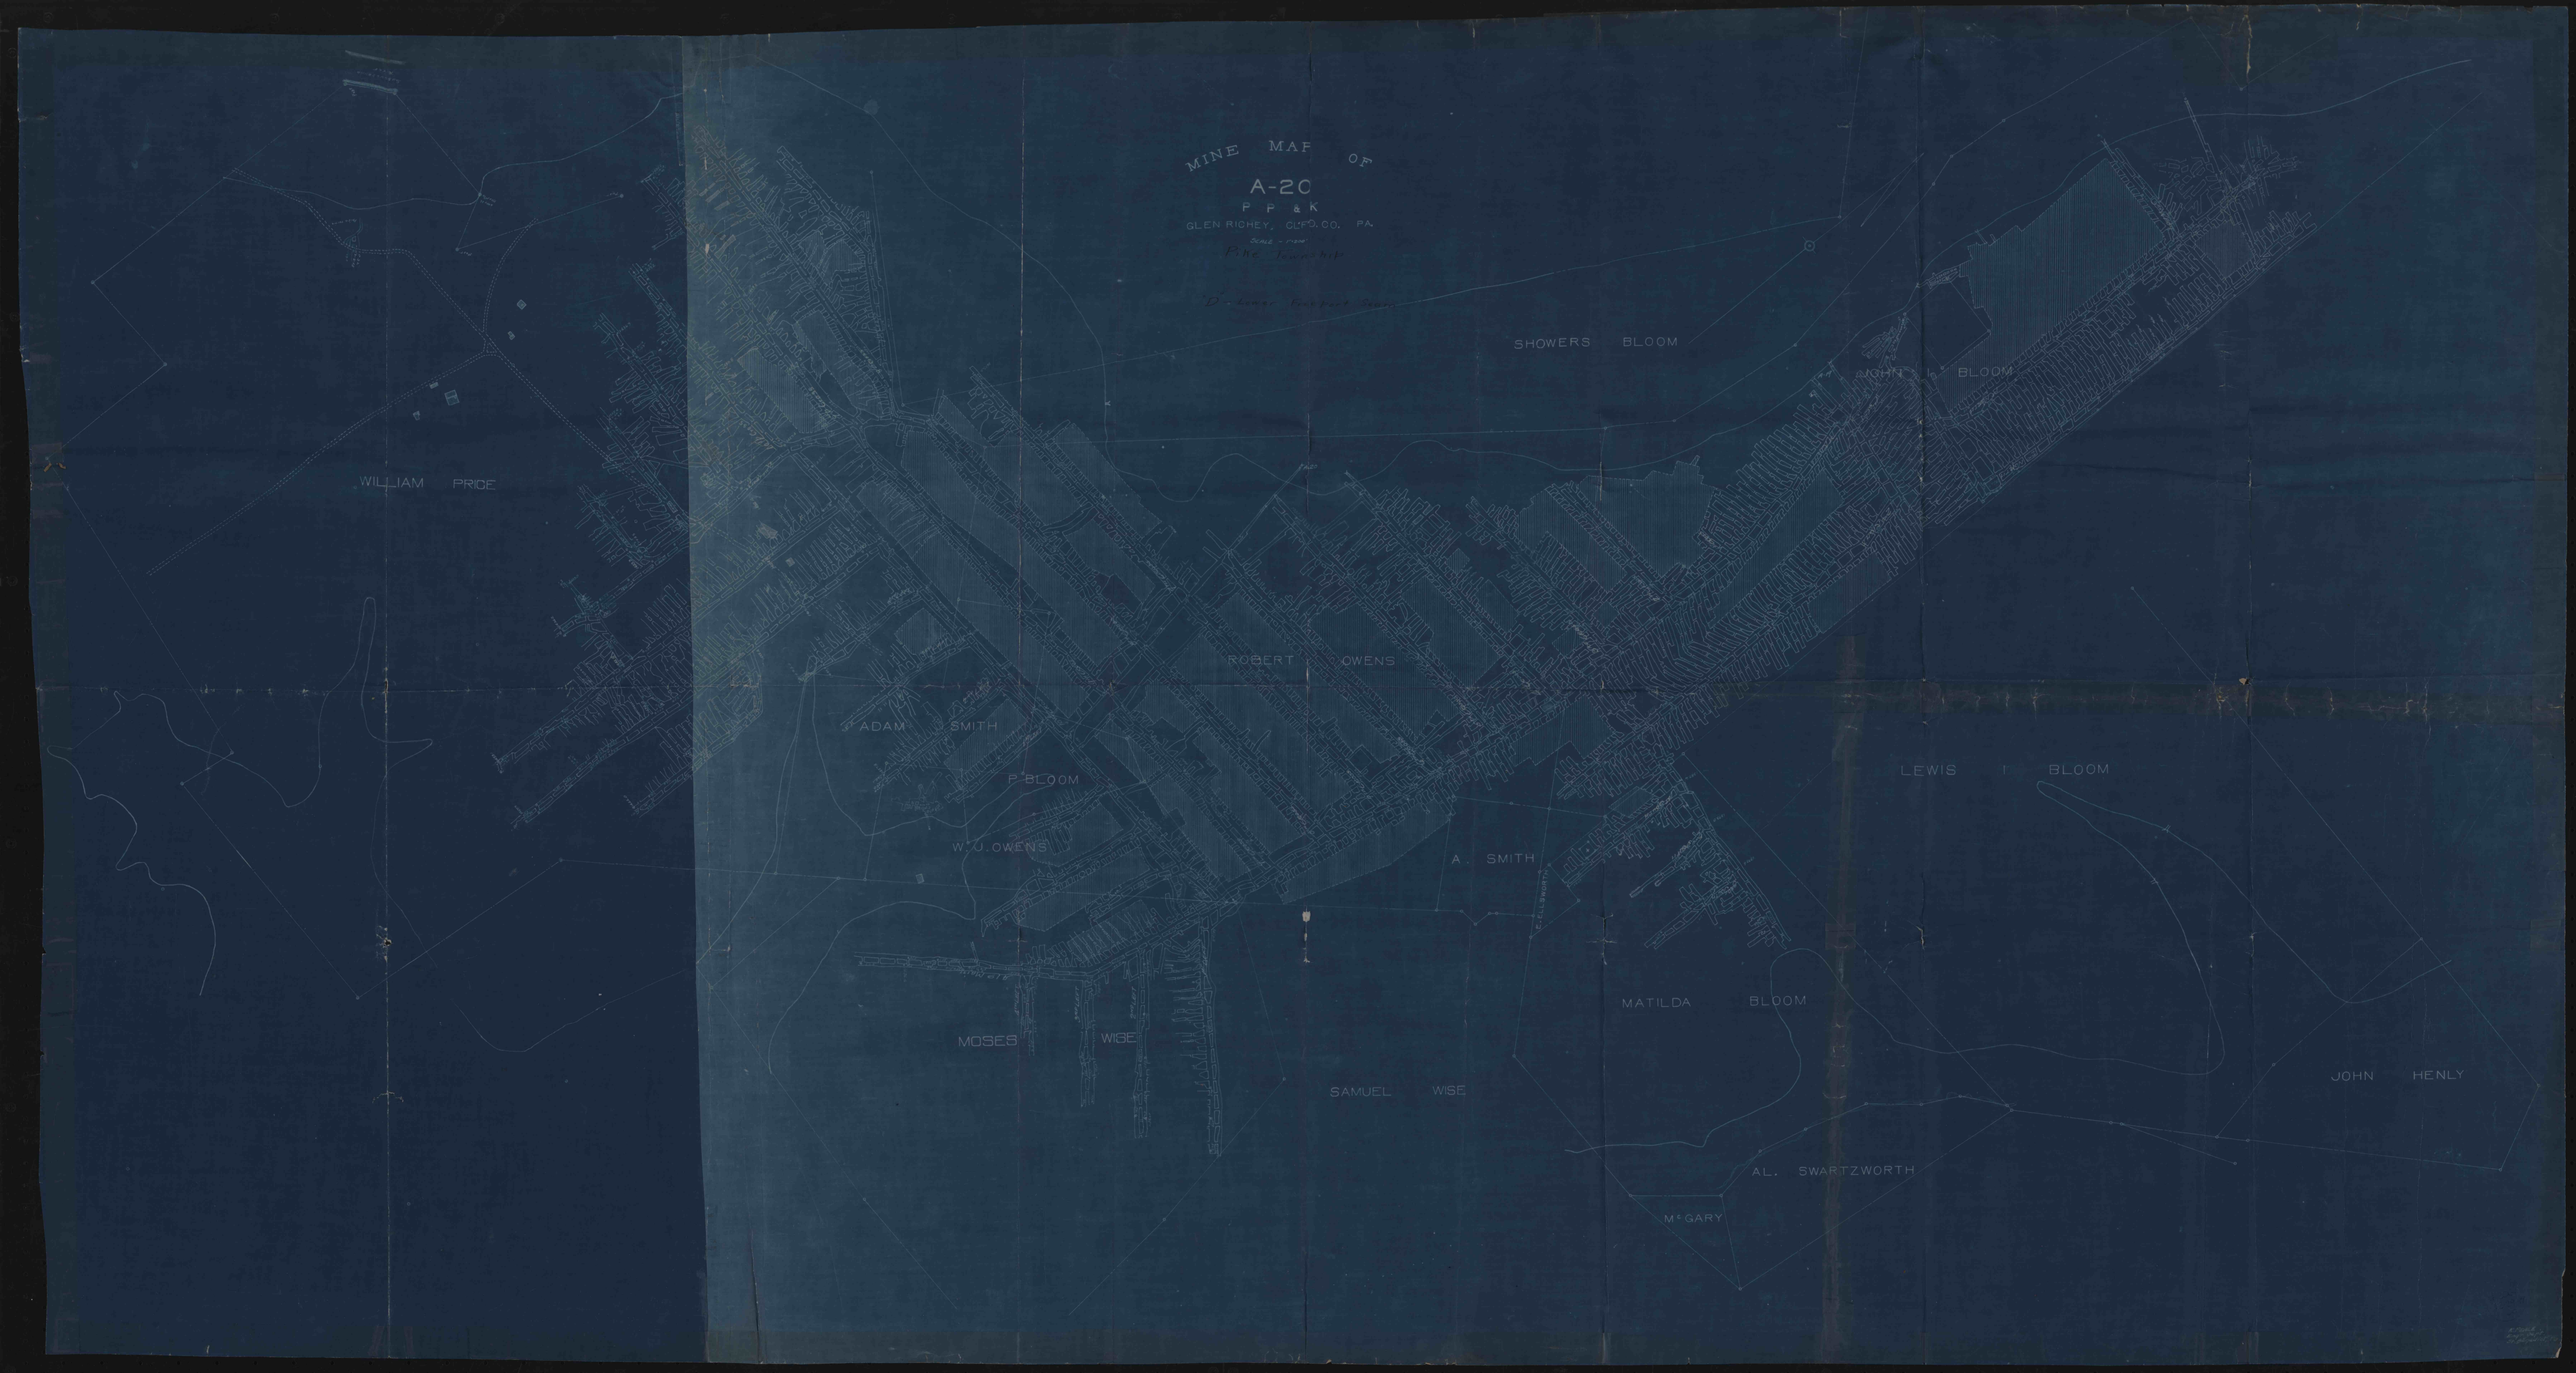
MINE MAP OF
A-20
P P & K
GLEN RICHEY, CLFD. CO. PA
WILLIAM PRICE
SHOWERS BLOOM
JOHN L. BLOOM
ROBERT L. OWENS
ADAM SMITH
P. BLOOM
W. O. OWENS
A. SMITH
LEWIS I. BLOOM
MATILDA BLOOM
MOSES WISE
SAMUEL WISE
JOHN HENLY
AL. SWARTZWORTH
Mc GARY