


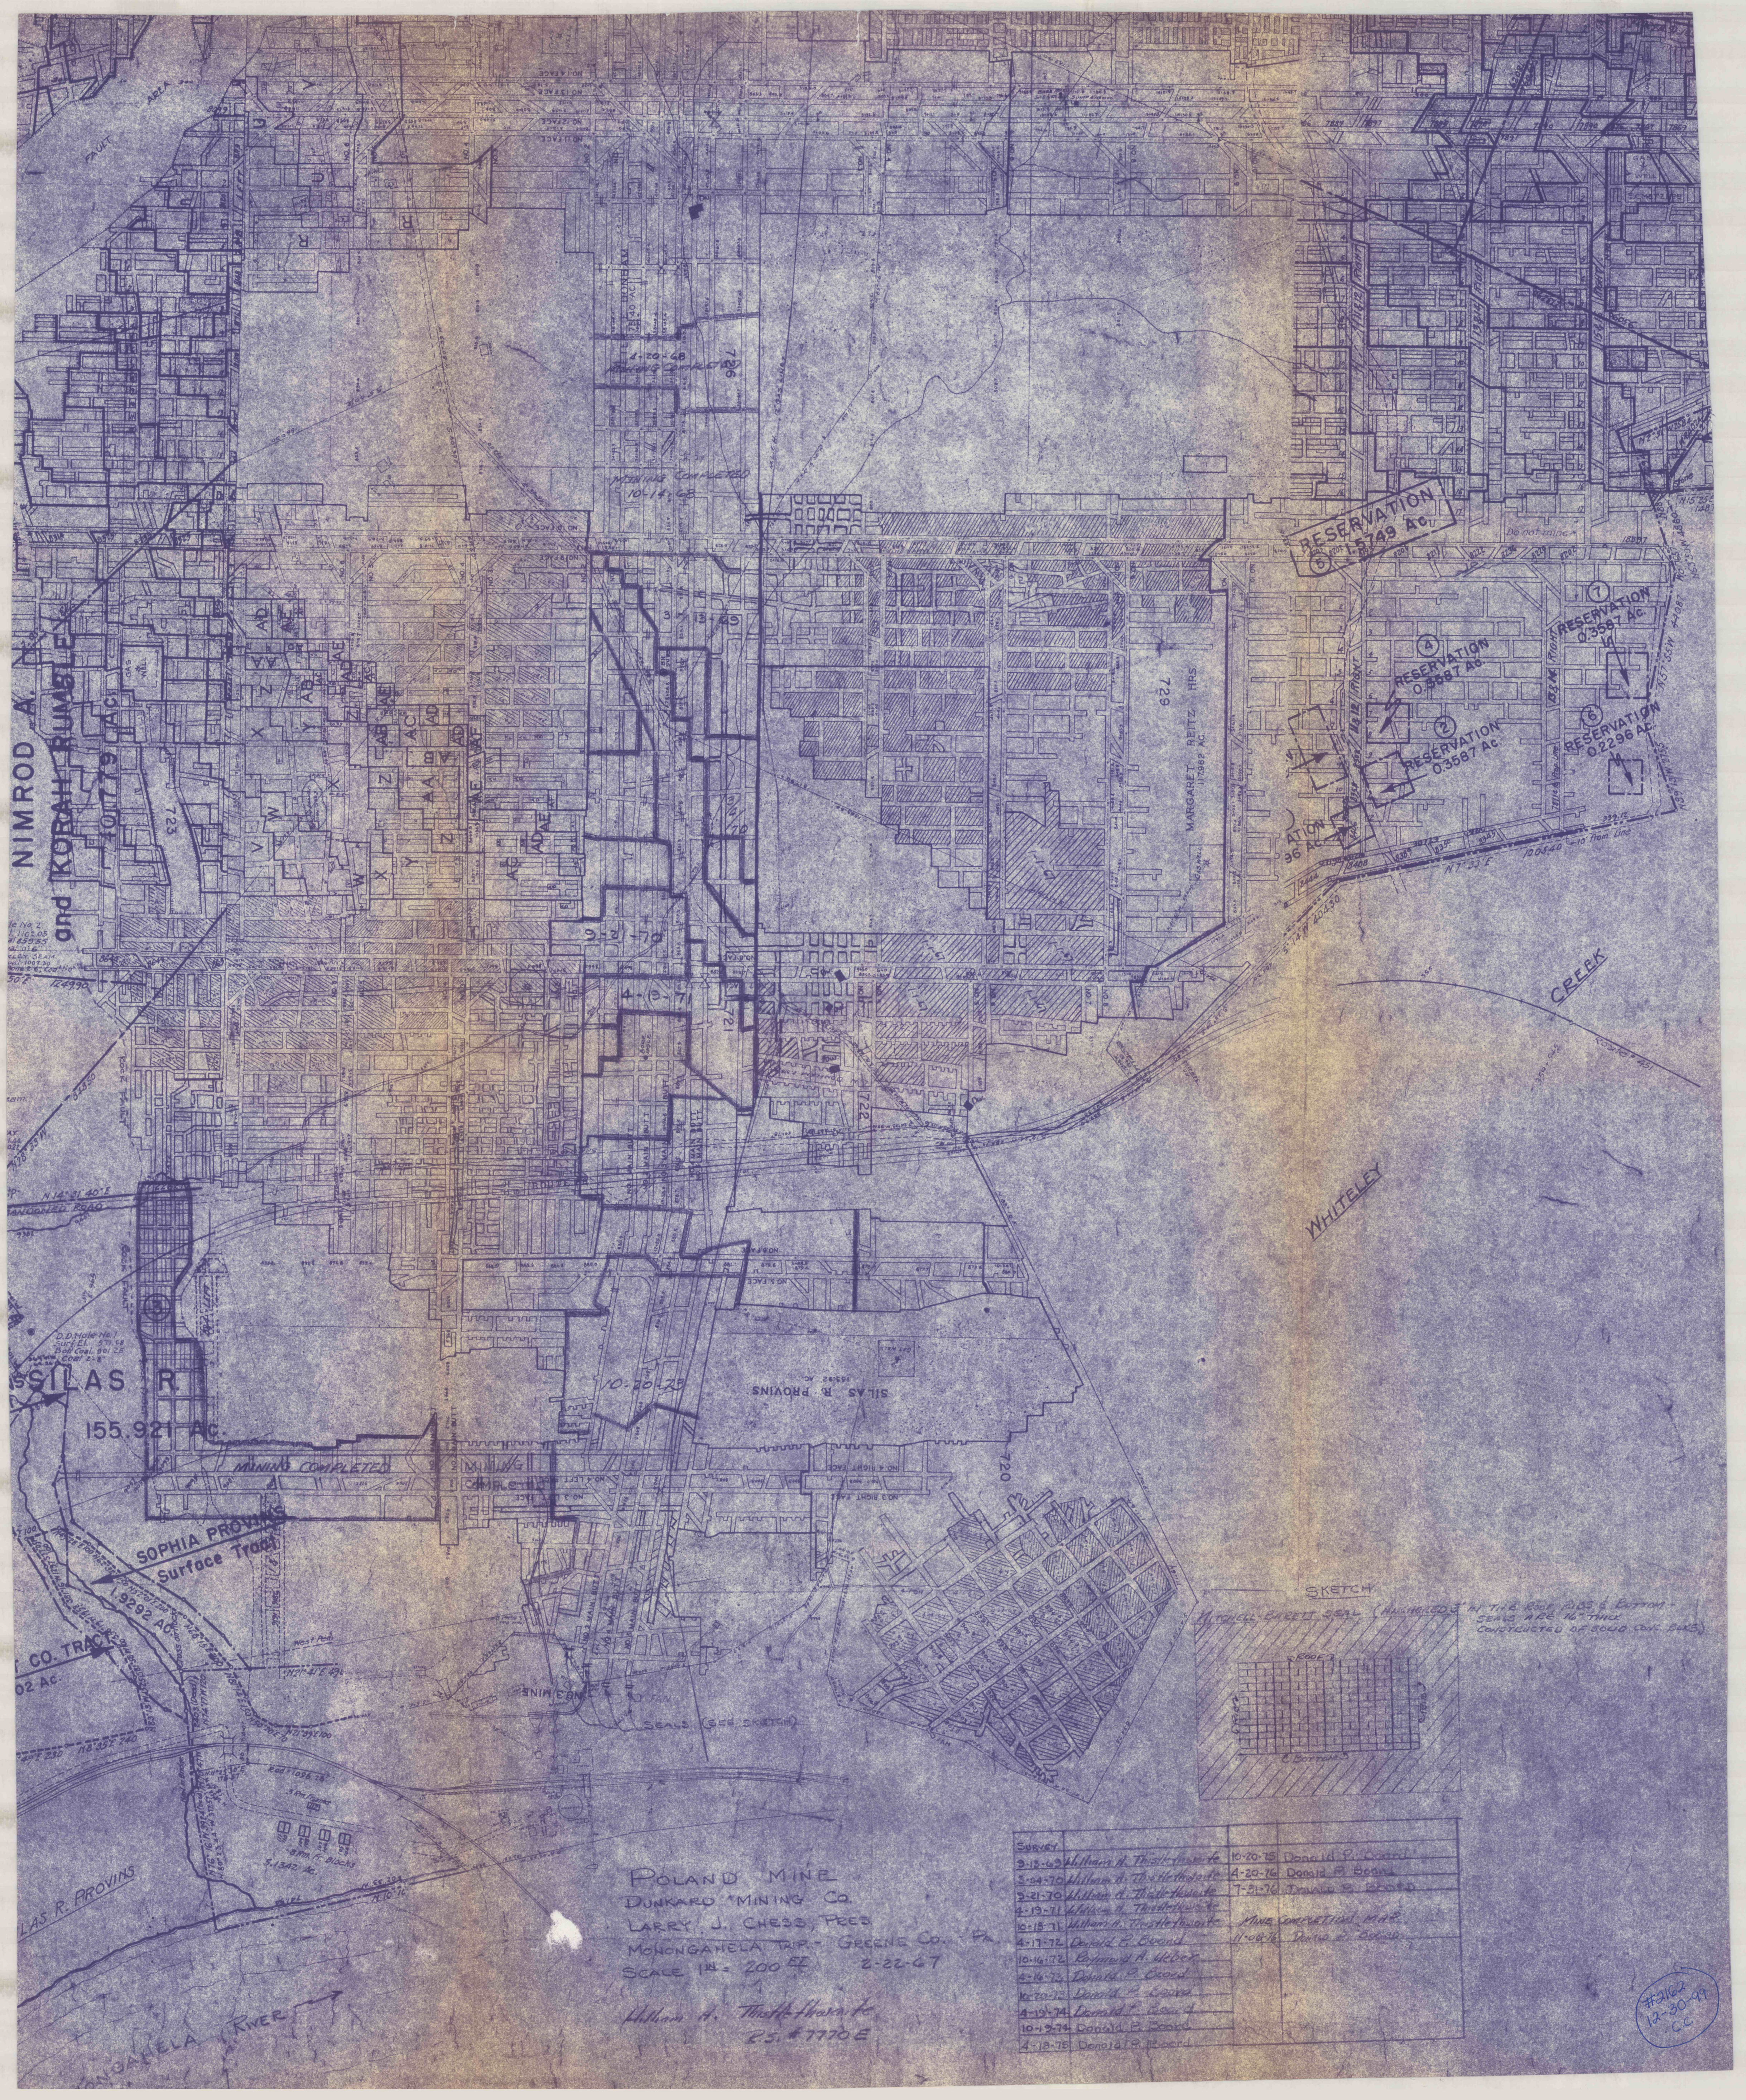

RESERVATION
15749 AC

RESERVATION
0.3587 AC

RESERVATION
0.3587 AC

RESERVATION
0.3587 AC

RESERVATION
0.2296 AC

WHITELEY

CREEK

SKETCH
MITCHELL SHEET SEAL (N. 1/4 SEC. 10, T. 10 S., R. 10 E., S. 10 E.)
SEAL ARE 16" THICK
CONSTRUCTED OF SOLID CONC. BLOCKS

POLAND MINE
DUNKARD MINING CO.
LARRY J. CHESSE, PRES
MONONGAHELA TRIP - GREENE CO. PA.
SCALE 1" = 200 FEET 2-22-67
William A. Thistlethwaite
P.S. #7770 E

Survey		
3-12-60 William A. Thistlethwaite	10-20-75 Donald P. Board	
3-24-70 William A. Thistlethwaite	4-20-76 Donald P. Board	
3-21-70 William A. Thistlethwaite	7-31-76 Donald P. Board	
4-19-71 William A. Thistlethwaite		Mine Completion Map
10-18-71 William A. Thistlethwaite	11-08-76 Donald P. Board	
4-17-72 Donald P. Board		
10-16-72 Raymond A. Board		
4-16-73 Donald P. Board		
10-20-73 Donald P. Board		
4-19-74 Donald P. Board		
10-19-74 Donald P. Board		
4-18-75 Donald P. Board		

#2162
12-30-99
C.C.