
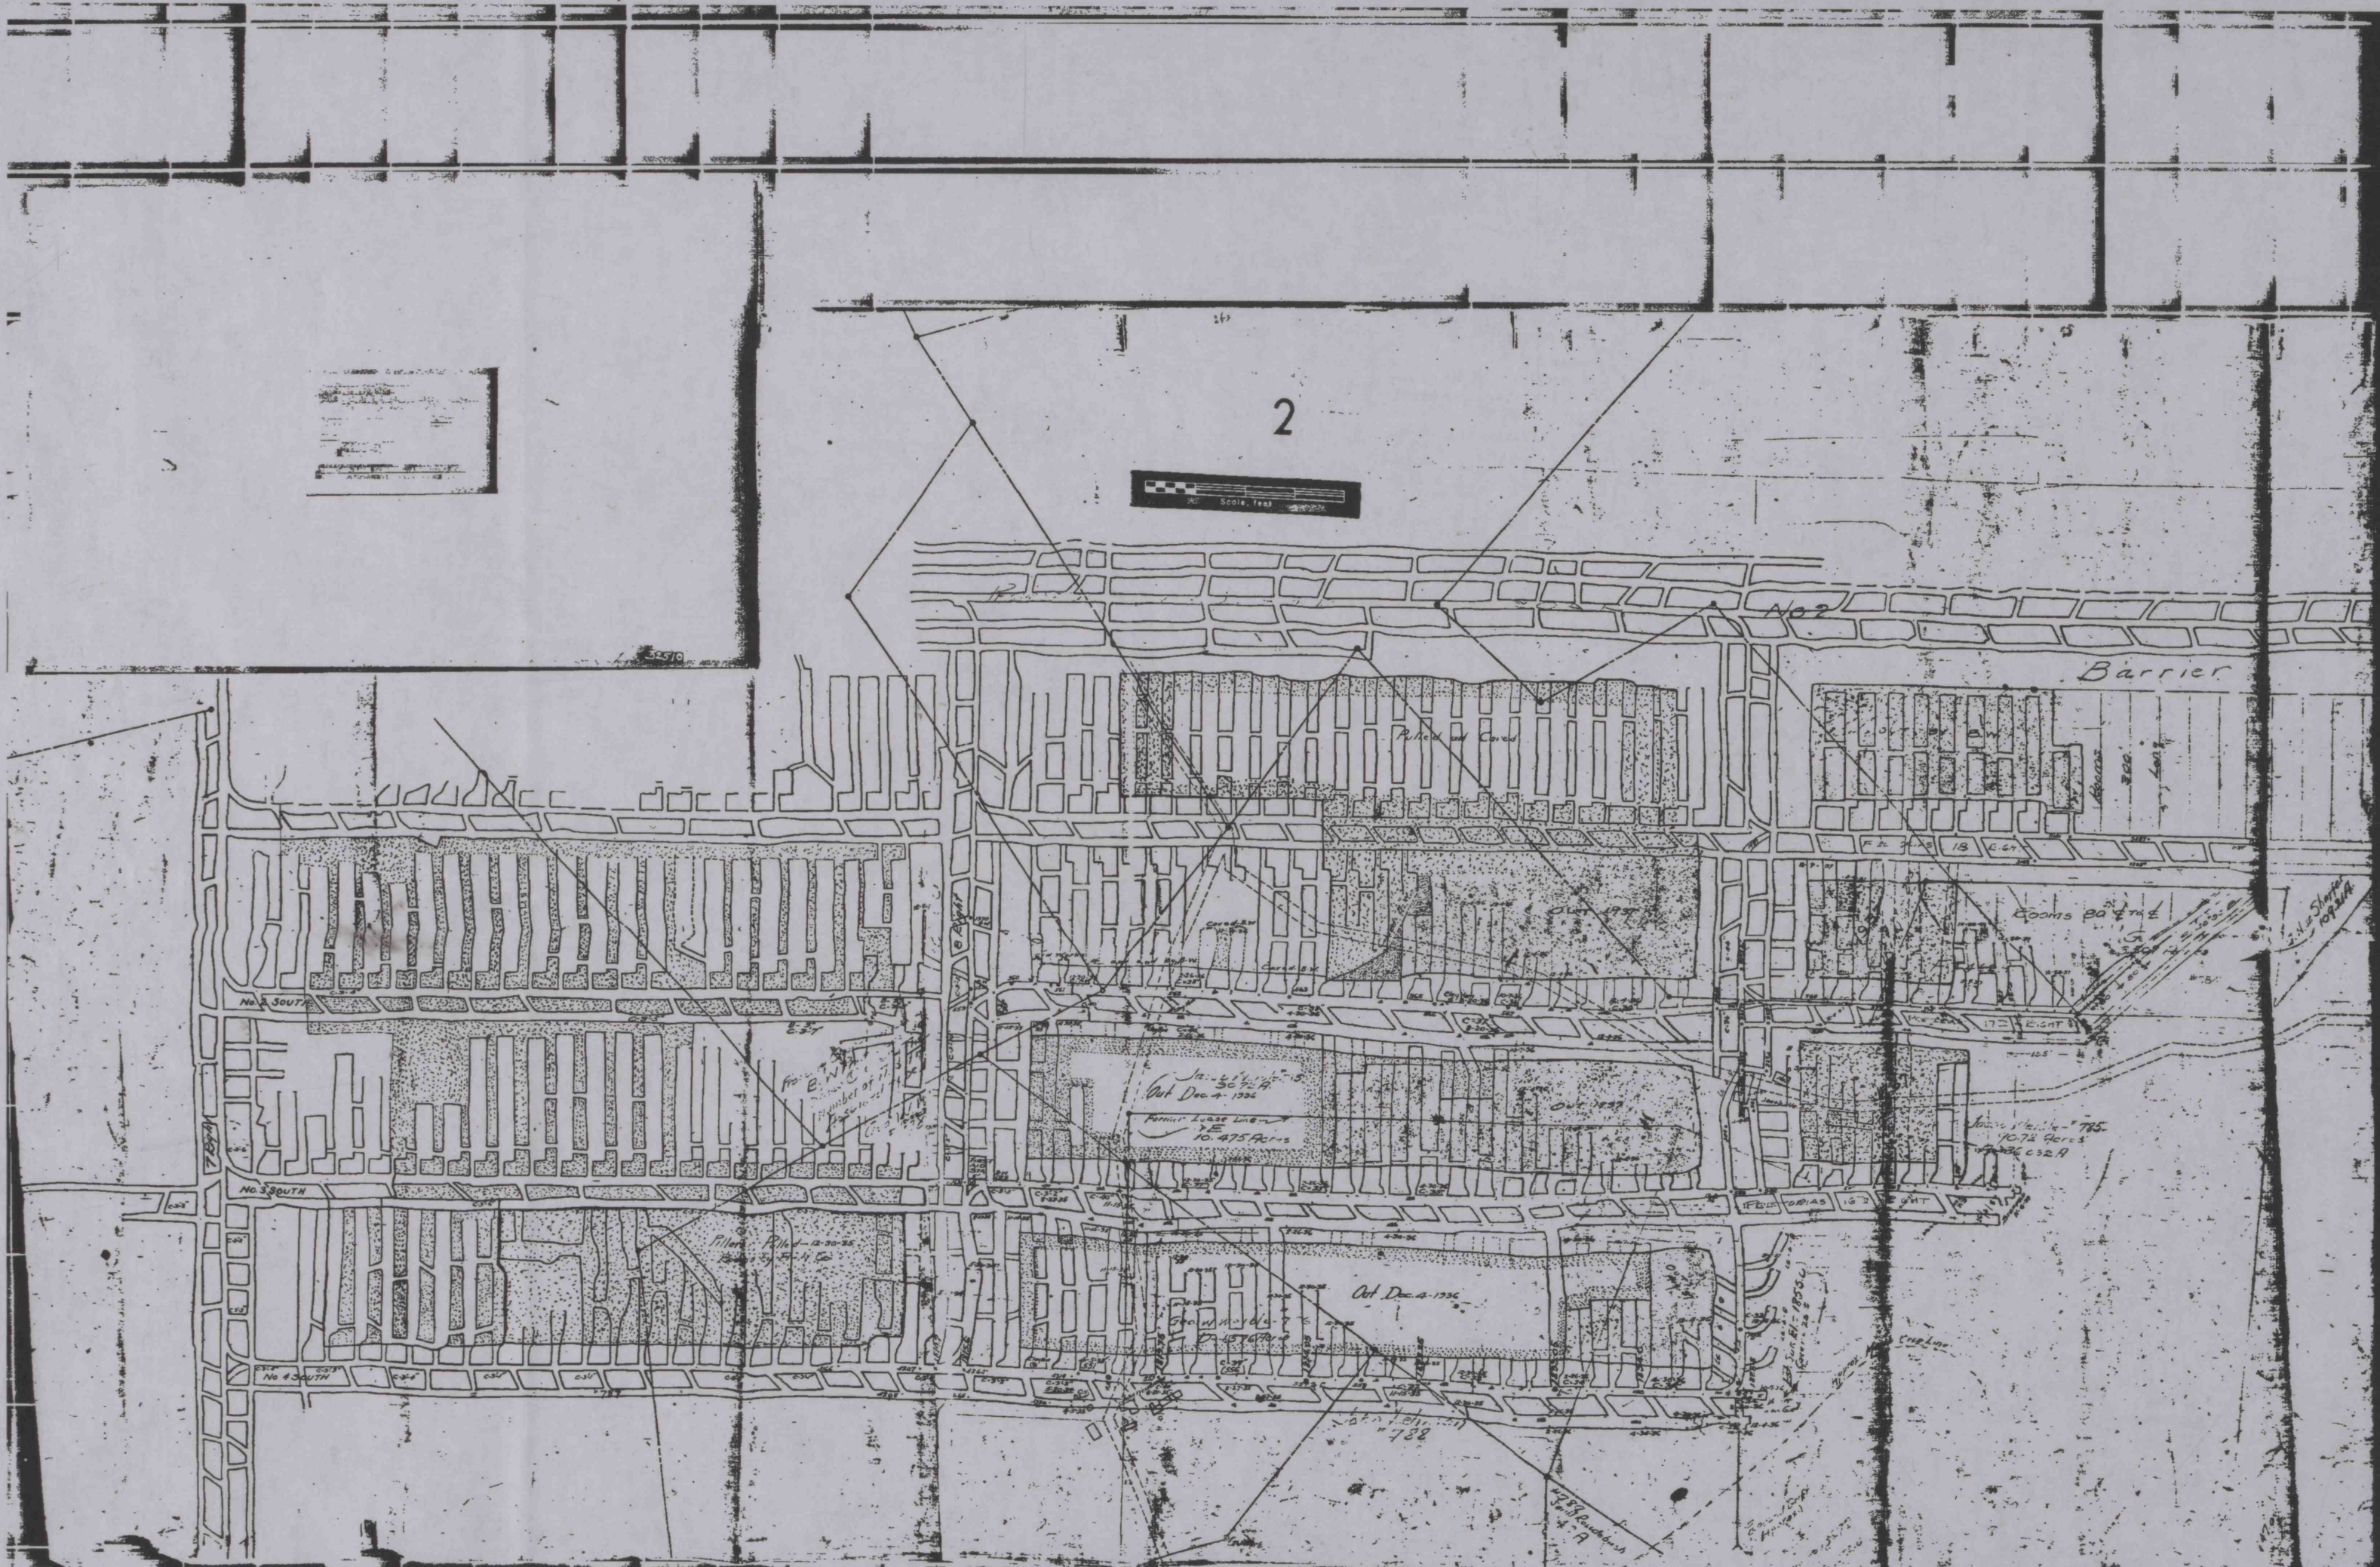


2

 

PDVMS 03070 375 31X 325101