

L. STORM (SURF.)

L.R. 11040

L. GATES (SURF.)

L. GATES (SURF.)


STATE GAME LANDS
NO. 108

STRIP MINED

AREA

CLEARFIELD TWP.
WHITE TWP.

- EXISTING MINING
- 6 MONTH PROJECTION 4/1/67 to 10/1/67
- PROPERTY BOUNDARY
- PERMIT AREA

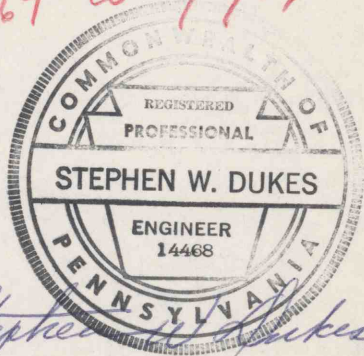

REVISIONS	
1	APRIL 1, 1967

COAL
DEAN EQUIPMENT CO.

SITUATE

CLEARFIELD & WHITE TWPS., CAMBRIA CO., PA.

SCALE: 1" = 200'

SEPT. 28, 1966

PLANS PREPARED BY
MINING DEPARTMENT
GWIN ENGINEERS INC.
CONSULTING ENGINEERS
ALTOONA, PA.

#2865
1-6-8000
C.C.