


RICH HILL No. 4 MINE
 WORKING AREAS - "D" SEAM
 MINING COMPLETED MARCH 31, 1967
 FINAL MAP
 SCALE 1" = 200'



Benjamin R. Auley

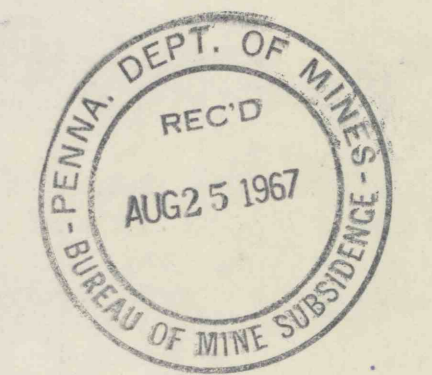

#2350
 1-10-2000
 C-2

D.O.M. 17
 ELEV. 2' 1553.78
 SHARLE ROOF
 C-13 - 8ans

D.O.M. 18
 ELEV. 2' 1485.97
 SHARLE ROOF
 C-18 - 8ans

D.O.M. 10
 ELEV. 2' 1222.6
 SHARLE ROOF
 C-22

D.O.M. 39
 ELEV. 2' 730.37
 JANASTONE ROOF
 C-192
 S. 1. 2
 S. 1. 2
 S. 1. 2
 C. 3.

D.O.M. 56
 ELEV. 2' 1460.9
 SHARLE ROOF
 C-192
 S. 1. 2
 S. 1. 2
 C. 3.

D.O.M. 54
 ELEV. 2' 1473.6
 SHARLE ROOF
 C-191

D.O.M. 24
 ELEV. 2' 1632.2
 SHARLE ROOF
 C-127 - 8ans

D.O.M. 38
 ELEV. 2' 1617.7
 SHARLE ROOF
 C-127

D.O.M. 37
 ELEV. 2' 1617.7
 SHARLE ROOF
 C-127

D.O.M. 9
 ELEV. 2' 1465.37
 SHARLE ROOF
 C-122
 S. 1. 2
 S. 1. 2
 C. 3.

