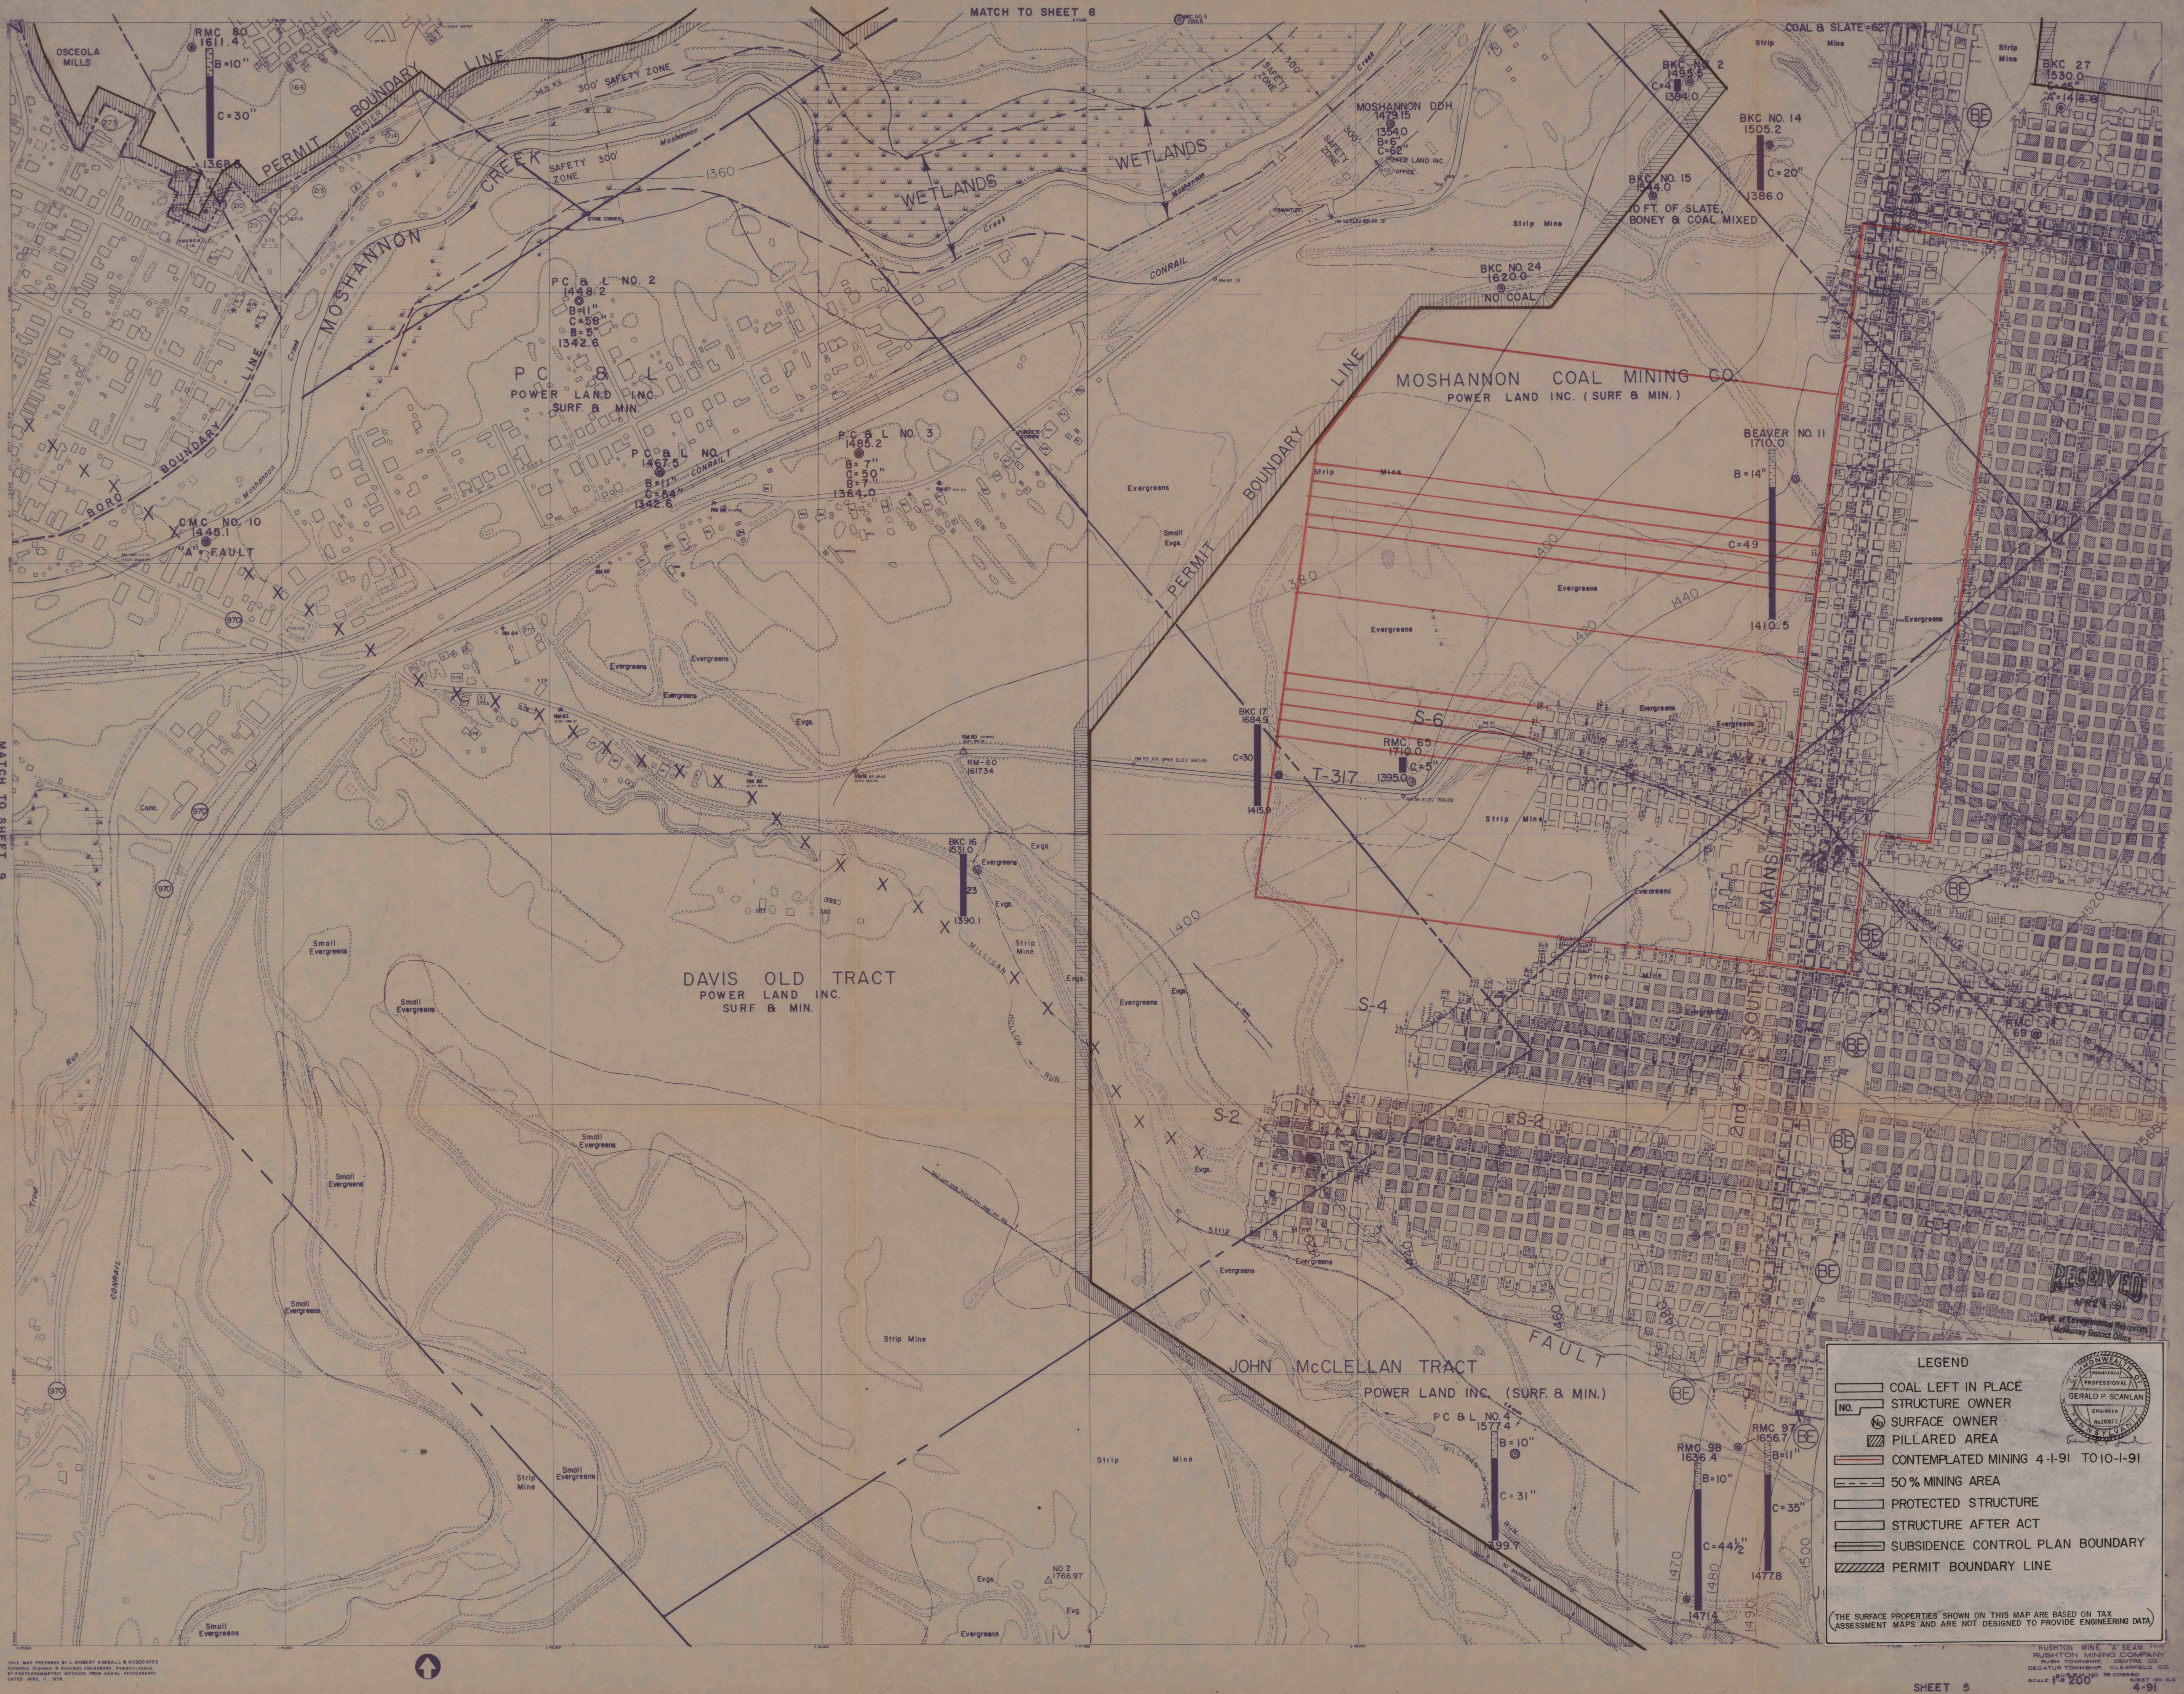
MATCH TO SHEET 6
MATCH TO SHEET 9
MATCH TO SHEET 1
OSCEOLA MILLS
RMC 80
1611.4
B=10"
C=30"
1368.6
PERMIT BOUNDARY LINE
50' BARRIER
345 KV
300' SAFETY ZONE
SAFETY 300' ZONE
MOSHANNON CREEK
Moshannon Creek
WETLANDS
WETLANDS
SAFETY ZONE 300'
MOSHANNON DDH
1479.15
1354.0
B=6"
C=62"
POWER LAND INC.
OFFICE
CONRAIL
1360
BORO BOUNDARY LINE
CHURCH 416
STONE CORNER
PC & L NO. 2
1448.2
B=11"
C=58"
B=5"
1342.6
PC & L
POWER LAND INC.
SURF. & MIN.
PC & L NO. 1
1467.5
B=11"
C=54"
1342.6
PC & L NO. 3
1485.2
B=7"
C=50"
B=7"
1364.0
CMC NO. 10
1445.1
"A" FAULT
970
Conc.
RUINS
Evergreens
Evgs.
Small Evgs.
Strip Mine
BKC NO. 5
1355.8
BKC NO. 2
1495.5
C=4"
1384.0
BKC NO. 14
1505.2
C=20"
1386.0
BKC NO. 15
1544.0
10 FT. OF SLATE, BONEY & COAL MIXED
BKC NO. 24
1620.0
NO COAL
COAL & SLATE=62"
BKC 27
1530.0
C=45"
"A"=1418.8
BE
MOSHANNON COAL MINING CO.
POWER LAND INC. (SURF. & MIN.)
BEAVER NO. 11
1710.0
B=14"
C=49
1410.5
1380
1400
1420
1440
BKC 17
1684.9
C=30
1415.9
T-317
RMC 65
1710.0
C=5"
1395.0
RM-60
1617.34
RM 59 RR SPIKE ELEV 1660.45
S-6
S-4
S-2
S-1
S-3
2nd SOUTH MAINS
TO OSCEOLA MILLS
RMC 69
BKC 16
1531.0
23
1390.1
MILLIGAN HOLLOW RUN
DAVIS OLD TRACT
POWER LAND INC.
SURF. & MIN.
Small Evergreens
Trout Run
CONRAIL
FAULT
JOHN McCLELLAN TRACT
POWER LAND INC. (SURF. & MIN.)
PC & L NO. 4
1577.4
B=10"
C=31"
1399.7
NO MINING THROUGH BARRIER
PERMIT BOUNDARY LINE
NO 2
1766.97
RMC 98
1636.4
B=10"
C=44½"
1471.4
RMC 97
1656.7
B=11"
C=35"
1477.8
1460
1470
1480
1490
1500
1520
1540
1560
RECEIVED
APR 24 1991
Dept. of Environmental Resources
McMurray District Office
LEGEND
COAL LEFT IN PLACE
NO. STRUCTURE OWNER
No SURFACE OWNER
PILLARED AREA
CONTEMPLATED MINING 4-1-91 TO 10-1-91
50% MINING AREA
PROTECTED STRUCTURE
STRUCTURE AFTER ACT
SUBSIDENCE CONTROL PLAN BOUNDARY
PERMIT BOUNDARY LINE
COMMONWEALTH OF PENNSYLVANIA
REGISTERED PROFESSIONAL
GERALD P. SCANLAN
ENGINEER
No. 24007-E
(THE SURFACE PROPERTIES SHOWN ON THIS MAP ARE BASED ON TAX ASSESSMENT MAPS AND ARE NOT DESIGNED TO PROVIDE ENGINEERING DATA)
THIS MAP PREPARED BY L. ROBERT KIMBALL & ASSOCIATES
Consulting Engineers & Architects EBENSBURG, PENNSYLVANIA,
BY PHOTOGRAMMETRIC METHODS FROM AERIAL PHOTOGRAPHY
DATED APRIL 11, 1979.
RUSHTON MINE "A" SEAM
RUSHTON MINING COMPANY
RUSH TOWNSHIP, CENTRE CO.
DECATUR TOWNSHIP, CLEARFIELD CO.
U.S.B.M. NO. 36 008560
SCALE: 1" = 200'
SHEET NO. K-4
SHEET 5
4-91