MORRIS RUN COAL MININ Co's

SEYMOUR MINE

Scale: 1" = 200'

OCTOBER 15TH, 1908.

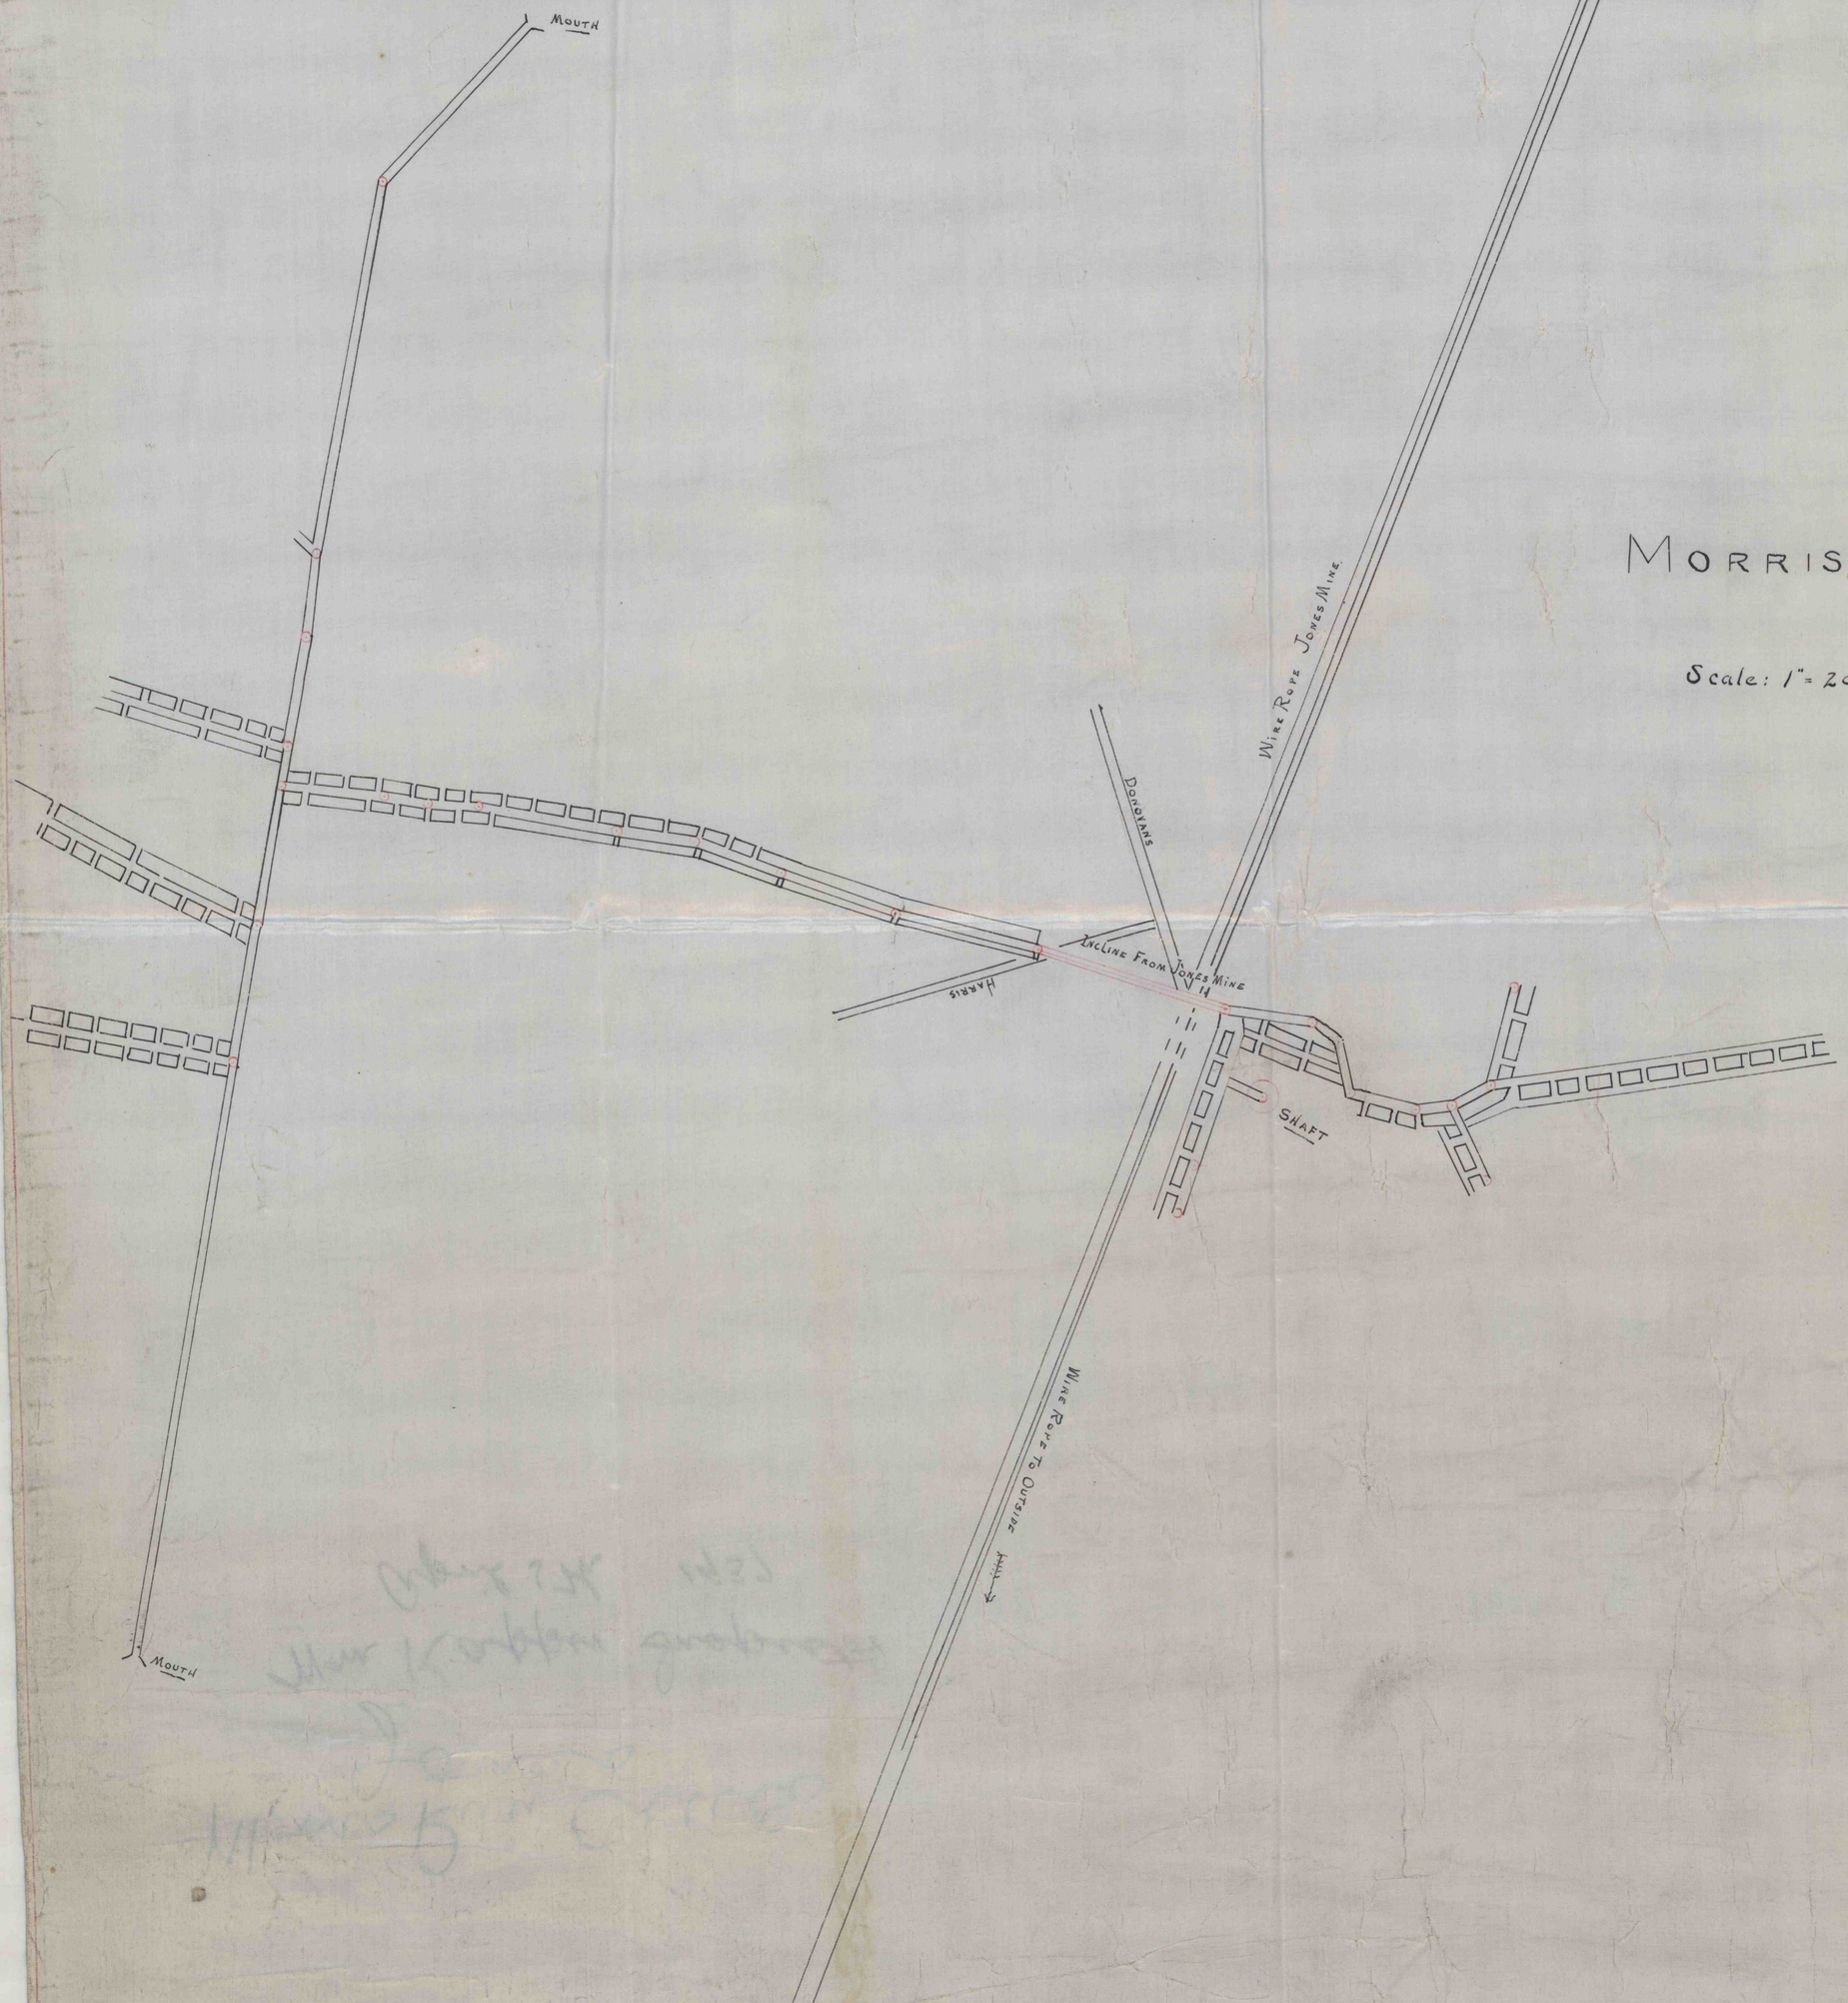

#2454
1-14-2000
CC