
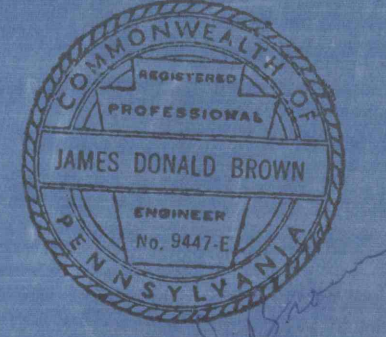


Underhill Coal Mining Co.
 Cascade Coal & Coke Co.
 Tyler Plant
 Plan Showing Mine Projection
 For No. 14 Mine
 Scale 1" = 200' Engineers Office

SURVEY EXTENDED TO Nov-14th-1930

AREA WORKED OUT 6-15-66 TO 12-30-66
 MINED CLOSED DEC. 30, 1966.

October 25, 1946 - J.H. [unclear]
 Nov. 26, 1947 " "
 Oct. 15, 1948 R.R.B.
 July 19, 1951 " "
 Feb. 19, 1952 " "
 Mar. 25, 1953 " "
 Dec. 19, 1955 " "
 Aug. 1, 1960 J.D.B.
 Dec. 30, 1966

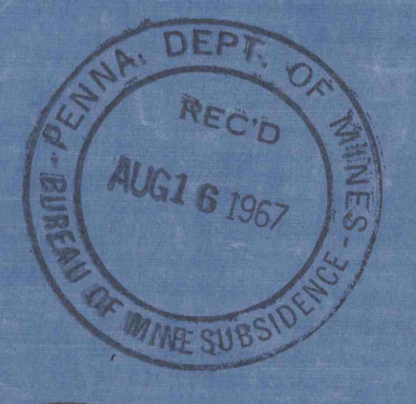

James [unclear]