


UNDERHILL COAL MINING CO. - FEE LANDS  
 HUSTON TOWNSHIP, CLEARFIELD COUNTY

Underhill Coal Mining Co.  
 Cascade Coal & Coke Co.  
 Tyler Plant  
 Plan Showing Mine Projection  
 For ~~North Mine~~ UNDERHILL MINE  
 Scale 1" = 200' Engineers Office

SURVEY EXTENDED TO Nov-14th-1930

October 25, 1926	J. H. Johnson
Nov. 26, 1927	J. H. Johnson
Oct. 15, 1928	R. R. B.
July 19, 1929	J. H. Johnson
Feb. 18, 1930	J. H. Johnson
Mar. 28, 1930	J. H. Johnson
Dec. 19, 1930	J. H. Johnson
Nov. 14, 1930	J. H. Johnson

PRESENT MINED OUT AREA  
 EXTENT OF MINING OPERATION  
 AREA PROPOSED TO BE MINED IF IS LC TO S-ASST  
 PROPERTY LINES

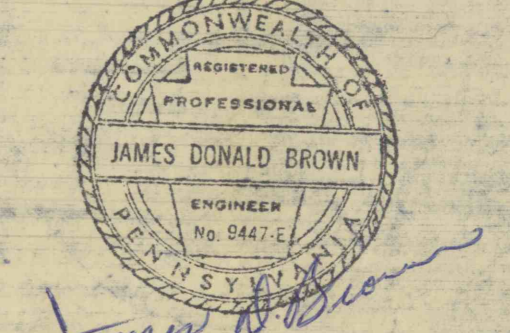

WORKED OUT AREA