MAP
of
WEST PENN MINING CO'S MINE
situate in
ALLEGHENY TWP.
WESTMORELAND CO. PA.

SCALE 1" = 200'
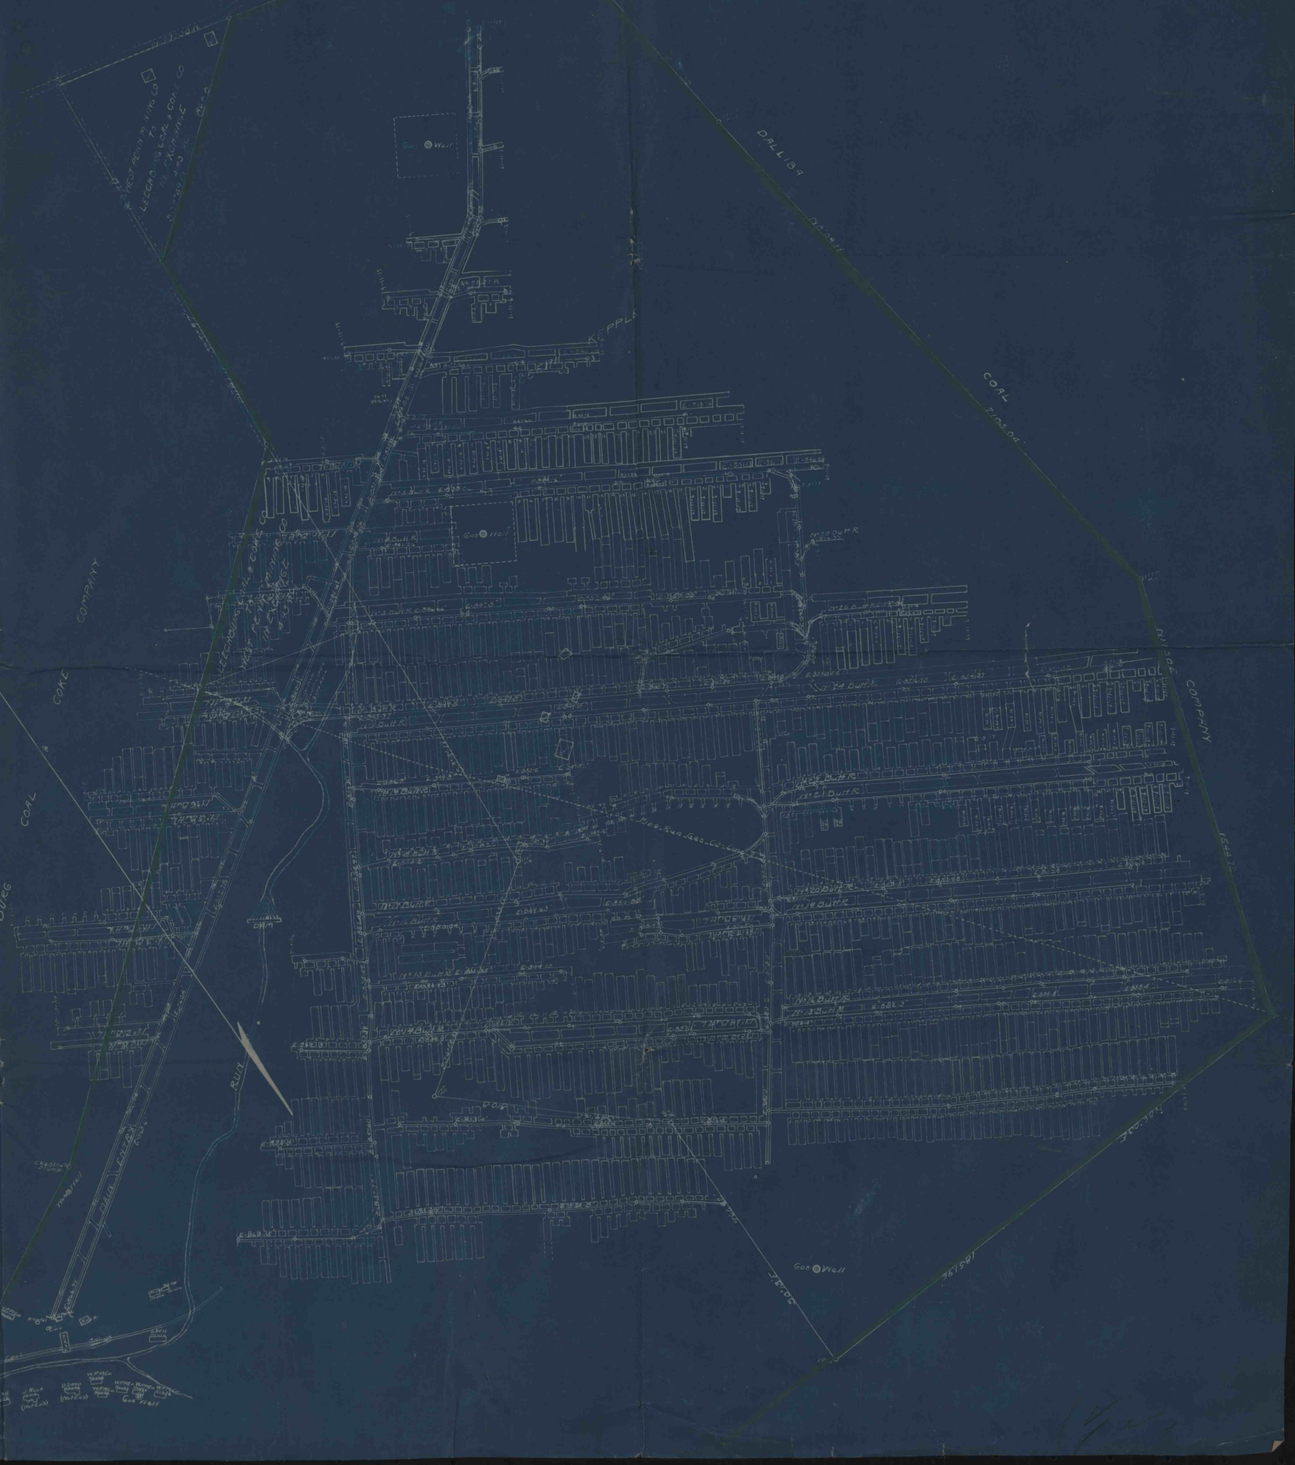
E.A. WATTERS Engr.