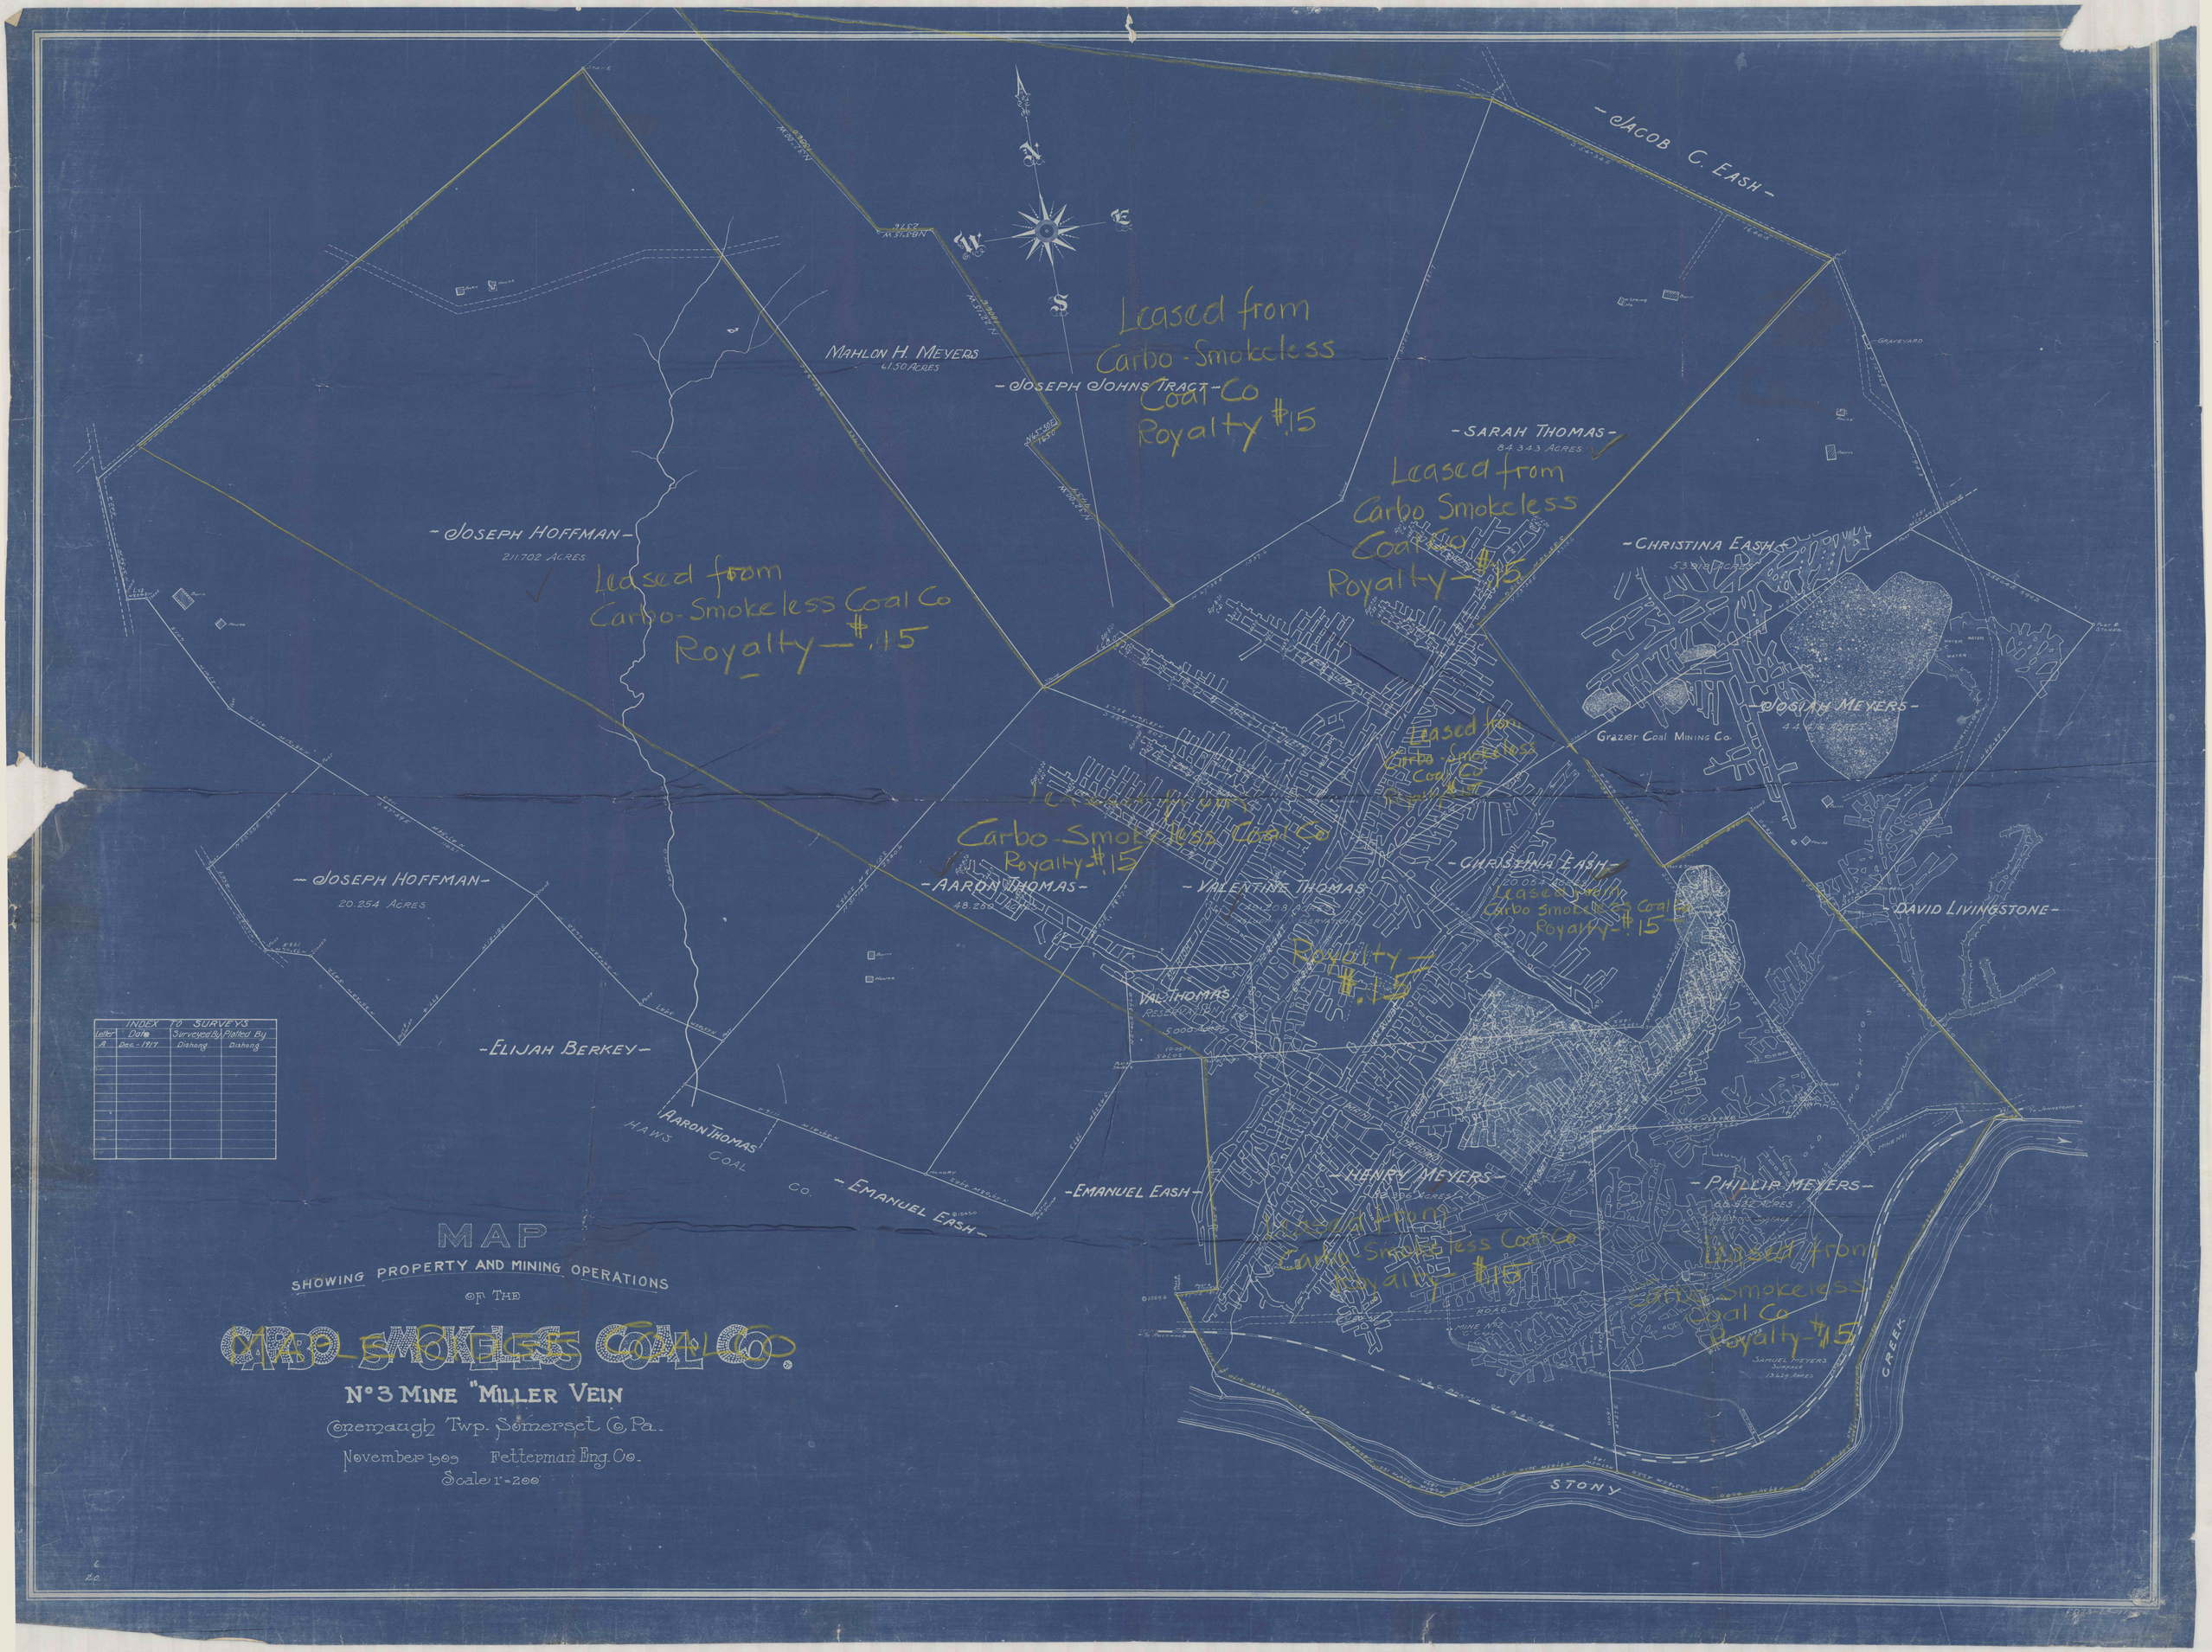
MAP
SHOWING PROPERTY AND MINING OPERATIONS
OF THE
CARBO SMOKELESS COAL CO.
No 3 MINE "MILLER VEIN
Conemaugh Twp. Somerset Co. Pa.
November 1909 Fetterman Eng. Co.
Scale 1"=200'
INDEX TO SURVEYS
Letter Date Surveyed By Plotted By
A Dec. 1917 Dishong Dishong
JACOB C. EASH
MAHLON H. MEYERS
61.50 ACRES
JOSEPH JOHNS TRACT
Leased from Carbo-Smokeless Coal Co Royalty $.15
SARAH THOMAS
84.343 ACRES
Leased from Carbo Smokeless Coal Co Royalty $.15
JOSEPH HOFFMAN
211.702 ACRES
Leased from Carbo-Smokeless Coal Co Royalty $.15
CHRISTINA EASH
JOSIAH MEYERS
Grazier Coal Mining Co.
Leased from Carbo-Smokeless Coal Co Royalty $.15
Leased from Carbo-Smokeless Coal Co Royalty $.15
JOSEPH HOFFMAN
20.254 ACRES
AARON THOMAS
48.200 ACRES
VALENTINE THOMAS
CHRISTINA EASH
Leased from Carbo Smokeless Coal Co Royalty $.15
DAVID LIVINGSTONE
Royalty $.15
VAL THOMAS
ELIJAH BERKEY
AARON THOMAS
HAWS COAL CO.
EMANUEL EASH
EMANUEL EASH
HENRY MEYERS
Leased from Carbo Smokeless Coal Co Royalty $.15
PHILLIP MEYERS
Leased from Carbo Smokeless Coal Co Royalty $.15
STONY
CREEK