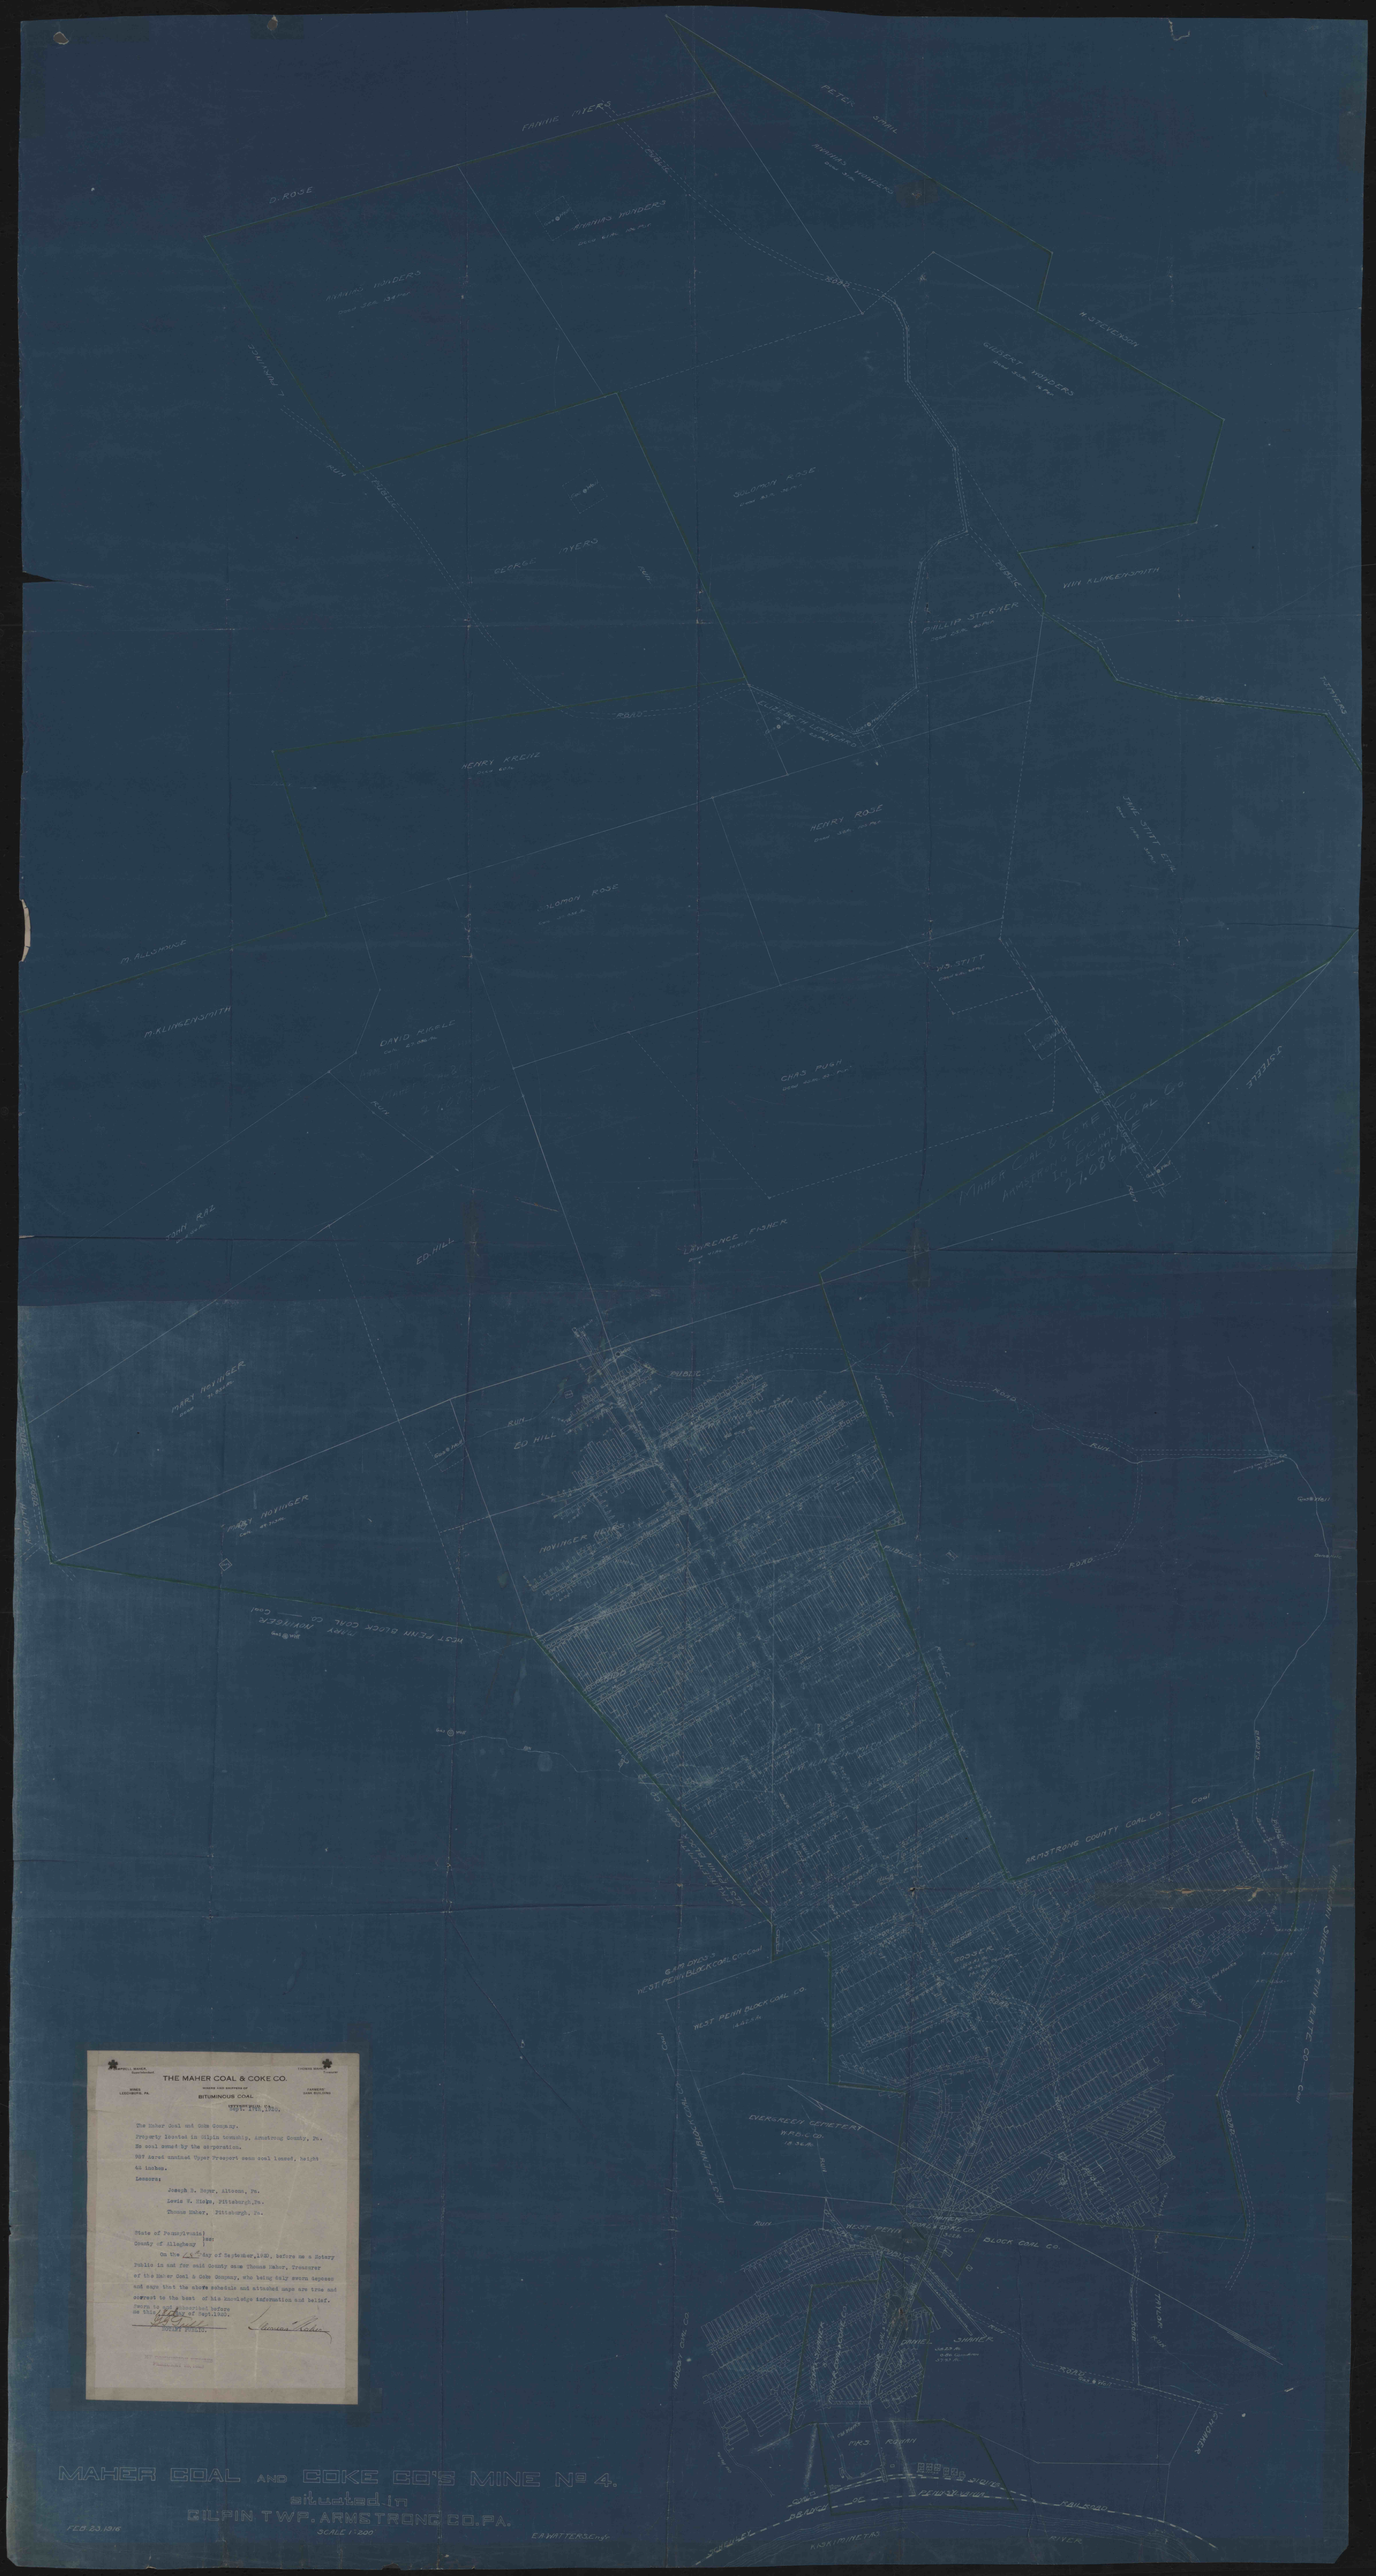

THE MAHER COAL & COKE CO.
MINING AND SHIPPERS OF
BITUMINOUS COAL
Capt. 2000,1000.
The Maher Coal and Coke Company.
Property located in Gilpin township, Armstrong County, Pa.
Be coal owned by the corporation.
987 Acres unmined Upper Freeport seam coal leased, height 44 inches.
Lessors:
Joseph B. Boyer, Altoona, Pa.
Lewis W. Hicks, Pittsburgh, Pa.
Thomas Maher, Pittsburgh, Pa.
State of Pennsylvania
County of Allegheny
On the 13th day of September, 1920, before me a Notary Public in and for said County came Thomas Maher, Treasurer of the Maher Coal & Coke Company, who being duly sworn deposes and says that the above schedule and attached maps are true and correct to the best of his knowledge information and belief.
Sworn to and subscribed before me this 13th day of Sept. 1920.
Notary Public.
MAHER COAL AND COKE CO'S MINE No 4.
situated in
GILPIN TWP. ARMSTRONG CO. PA.
SCALE 1"=200'
FEB. 23. 1916
E.A. WATTERS, Eng.