



6

6

MATCH SHEET 6 N9.000

MATCH SHEET 8 N4.000


MATCH SHEET 10 E2.000

MATCH SHEET 12 N1.000

9

9

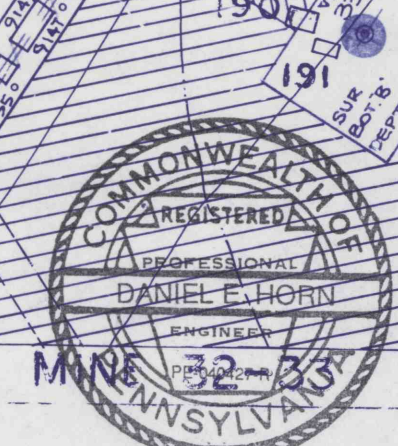

REVISED 1-86  
FINAL