


ALL MINING COMPLETED - JANUARY 29, 1982  
**-FINAL MAP-**

PREPARED FOR  
**VALLEY COAL CO., INC.**  
 VALLEY NO. 12 MINE  
 LOWER FREEPORT COAL SEAM  
 SITUATE  
 PINE TOWNSHIP, INDIANA COUNTY,  
 PENNSYLVANIA

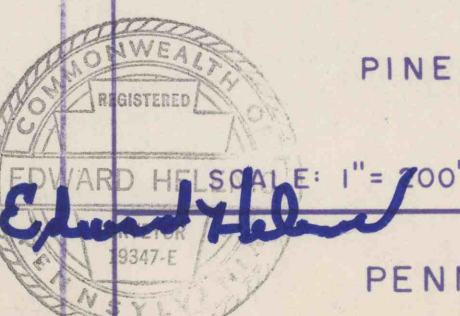

MAY 12, 1982  
 PREPARED BY  
**PENN-BRITANNICA CONSULTANTS**  
 BOX E, ARMAGH, PA. 15920  
 Cabinet M Drawer 1

LIMITS OF MINING PERMIT