



Proposed Mine Seal Locations

APPROVAL LEGEND


Valley Coal Co., Inc. COMPANY	
Valley No. 12 Mine NAME OF MINE	
Mine Seal Design and Location SUBJECT OF APPROVAL	
<i>David Vehovic, Dept. 7/20/82</i> COMPANY REPRESENTATIVE	DATE
<i>Radell M. Mason</i> ENGINEER	7-20-82 DATE
COMMISSIONER, OFFICE OF DEEP MINE SAFETY DEPARTMENT OF ENVIRONMENTAL RESOURCES	7/20/82 DATE
DIRECTOR, BITUMINOUS DEEP MINE SAFETY DEPARTMENT OF ENVIRONMENTAL RESOURCES	DATE
DISTRICT MINE INSPECTOR DEPARTMENT OF ENVIRONMENTAL RESOURCES	DATE

ALL MINING COMPLETED - JANUARY 29, 1982

-FINAL MAP-

PREPARED FOR
VALLEY COAL CO., INC.
VALLEY NO. 12 MINE
LOWER FREEPORT COAL SEAM
SITUATE
PINE TOWNSHIP, INDIANA COUNTY,
PENNSYLVANIA

SCALE: 1" = 200'
JULY 16, 1982
PREPARED BY
PENN-BRITANNICA CONSULTANTS
BOX E, ARMAD, PA. 15220

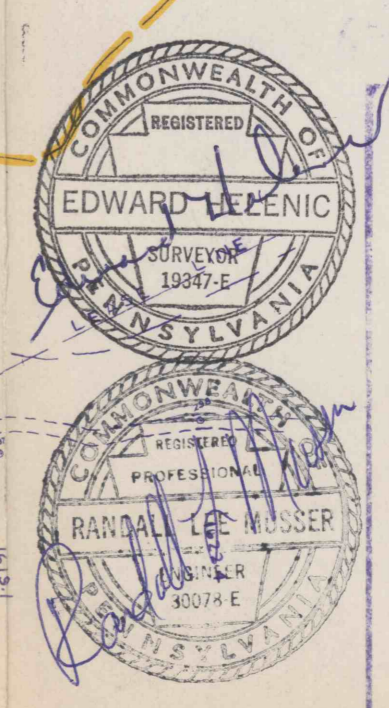

LIMITS OF MINING PERMIT