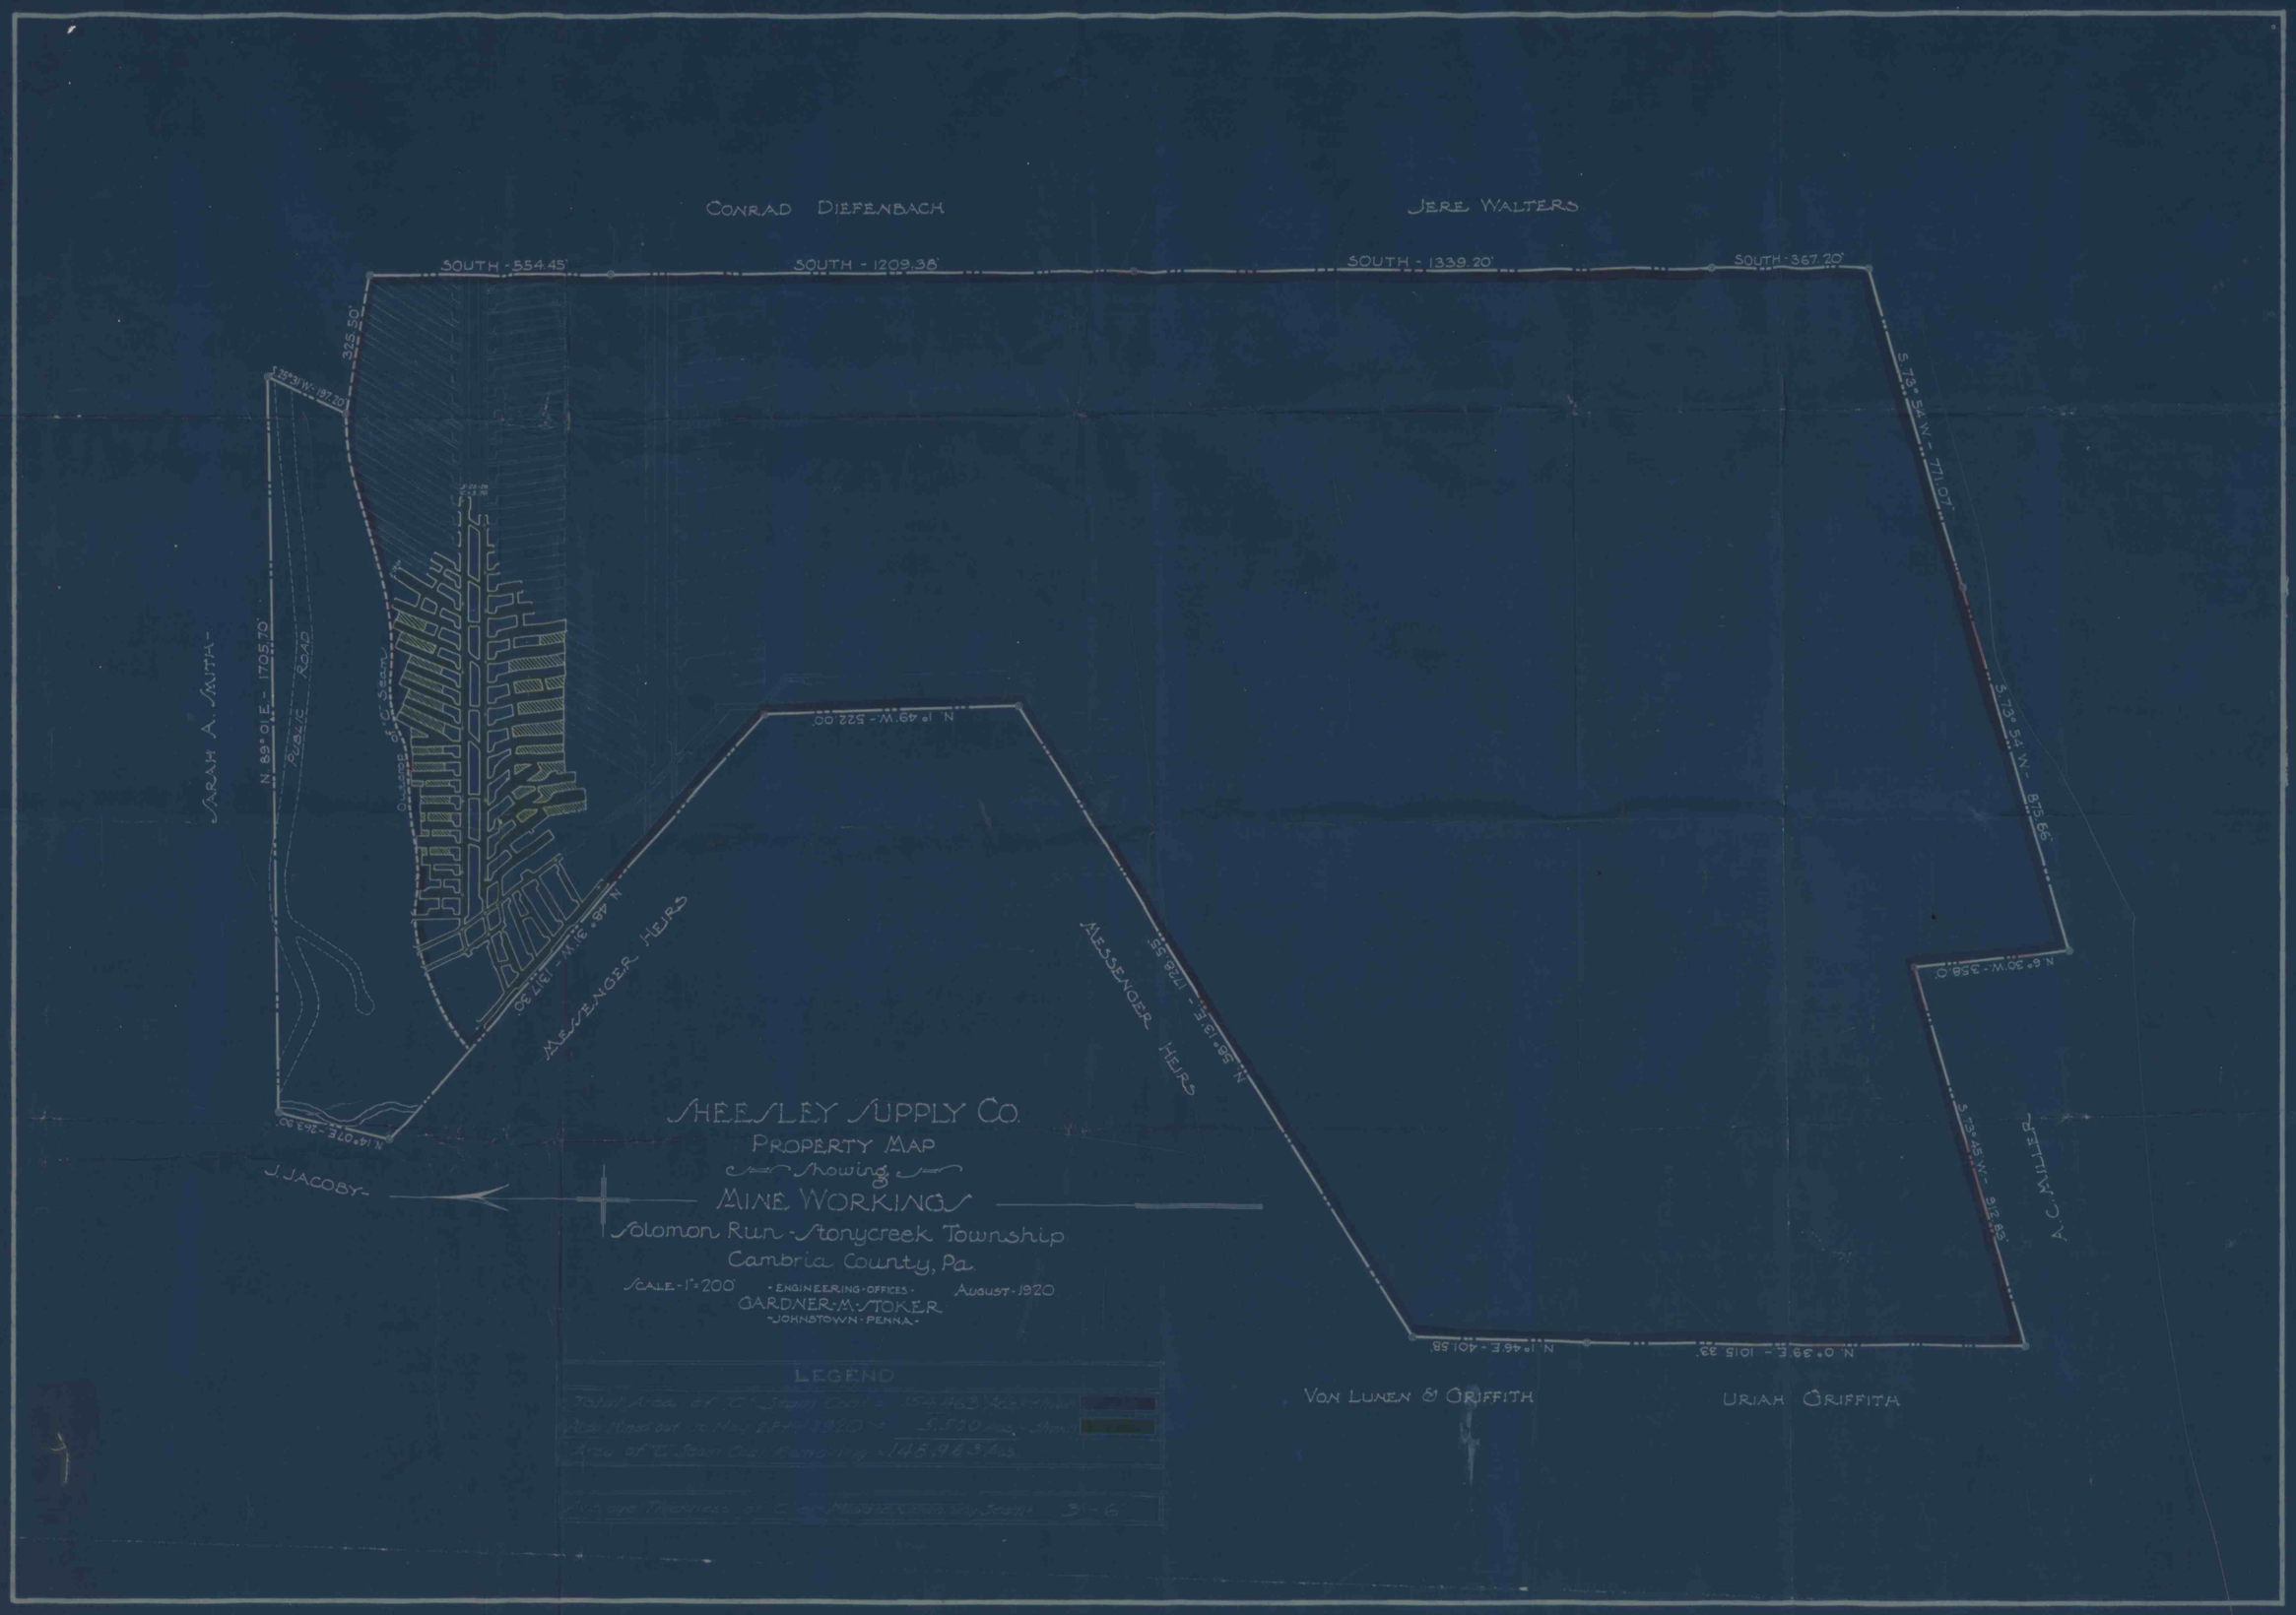
CONRAD DIEFENBACH
JERE WALTERS
SOUTH - 554.45'
SOUTH - 1209.38'
SOUTH - 1339.20'
SOUTH - 367.20'
325.50'
S 25°31' W - 197.20'
S 73° 54' W - 771.07'
S 73° 54' W - 875.66'
N 89° 01' E - 1705.70'
PUBLIC ROAD
SARAH A. SMITH
Outcrop of "C" Seam
N 1° 49' W - 522.00'
N 48° 31' W - 1317.30'
MESSENGER HEIRS
N 58° 13' E - 1728.55'
MESSENGER HEIRS
N 6° 30' W - 358.0'
S 73° 45' W - 912.83'
A. C. MILLER
N 14° 07' E - 263.90'
J. JACOBY
SHEESLEY SUPPLY CO.
PROPERTY MAP
Showing
MINE WORKINGS
Solomon Run - Stonycreek Township
Cambria County, Pa.
SCALE - 1" = 200'
ENGINEERING OFFICES
GARDNER-M-STOKER
JOHNSTOWN - PENNA.
AUGUST - 1920
N 1° 46' E - 401.58'
N 0° 39' E - 1015.33'
VON LUNEN & GRIFFITH
URIAH GRIFFITH
LEGEND
Total Area of "C" Seam Coal = 154.463 Acres
Area Mined out to Nov 28th 1920 = 5.500 Acres
Area of "C" Seam Coal Remaining = 148.963 Acres
Average Thickness of "C" or Middle Kittanning Seam = 3'-6"