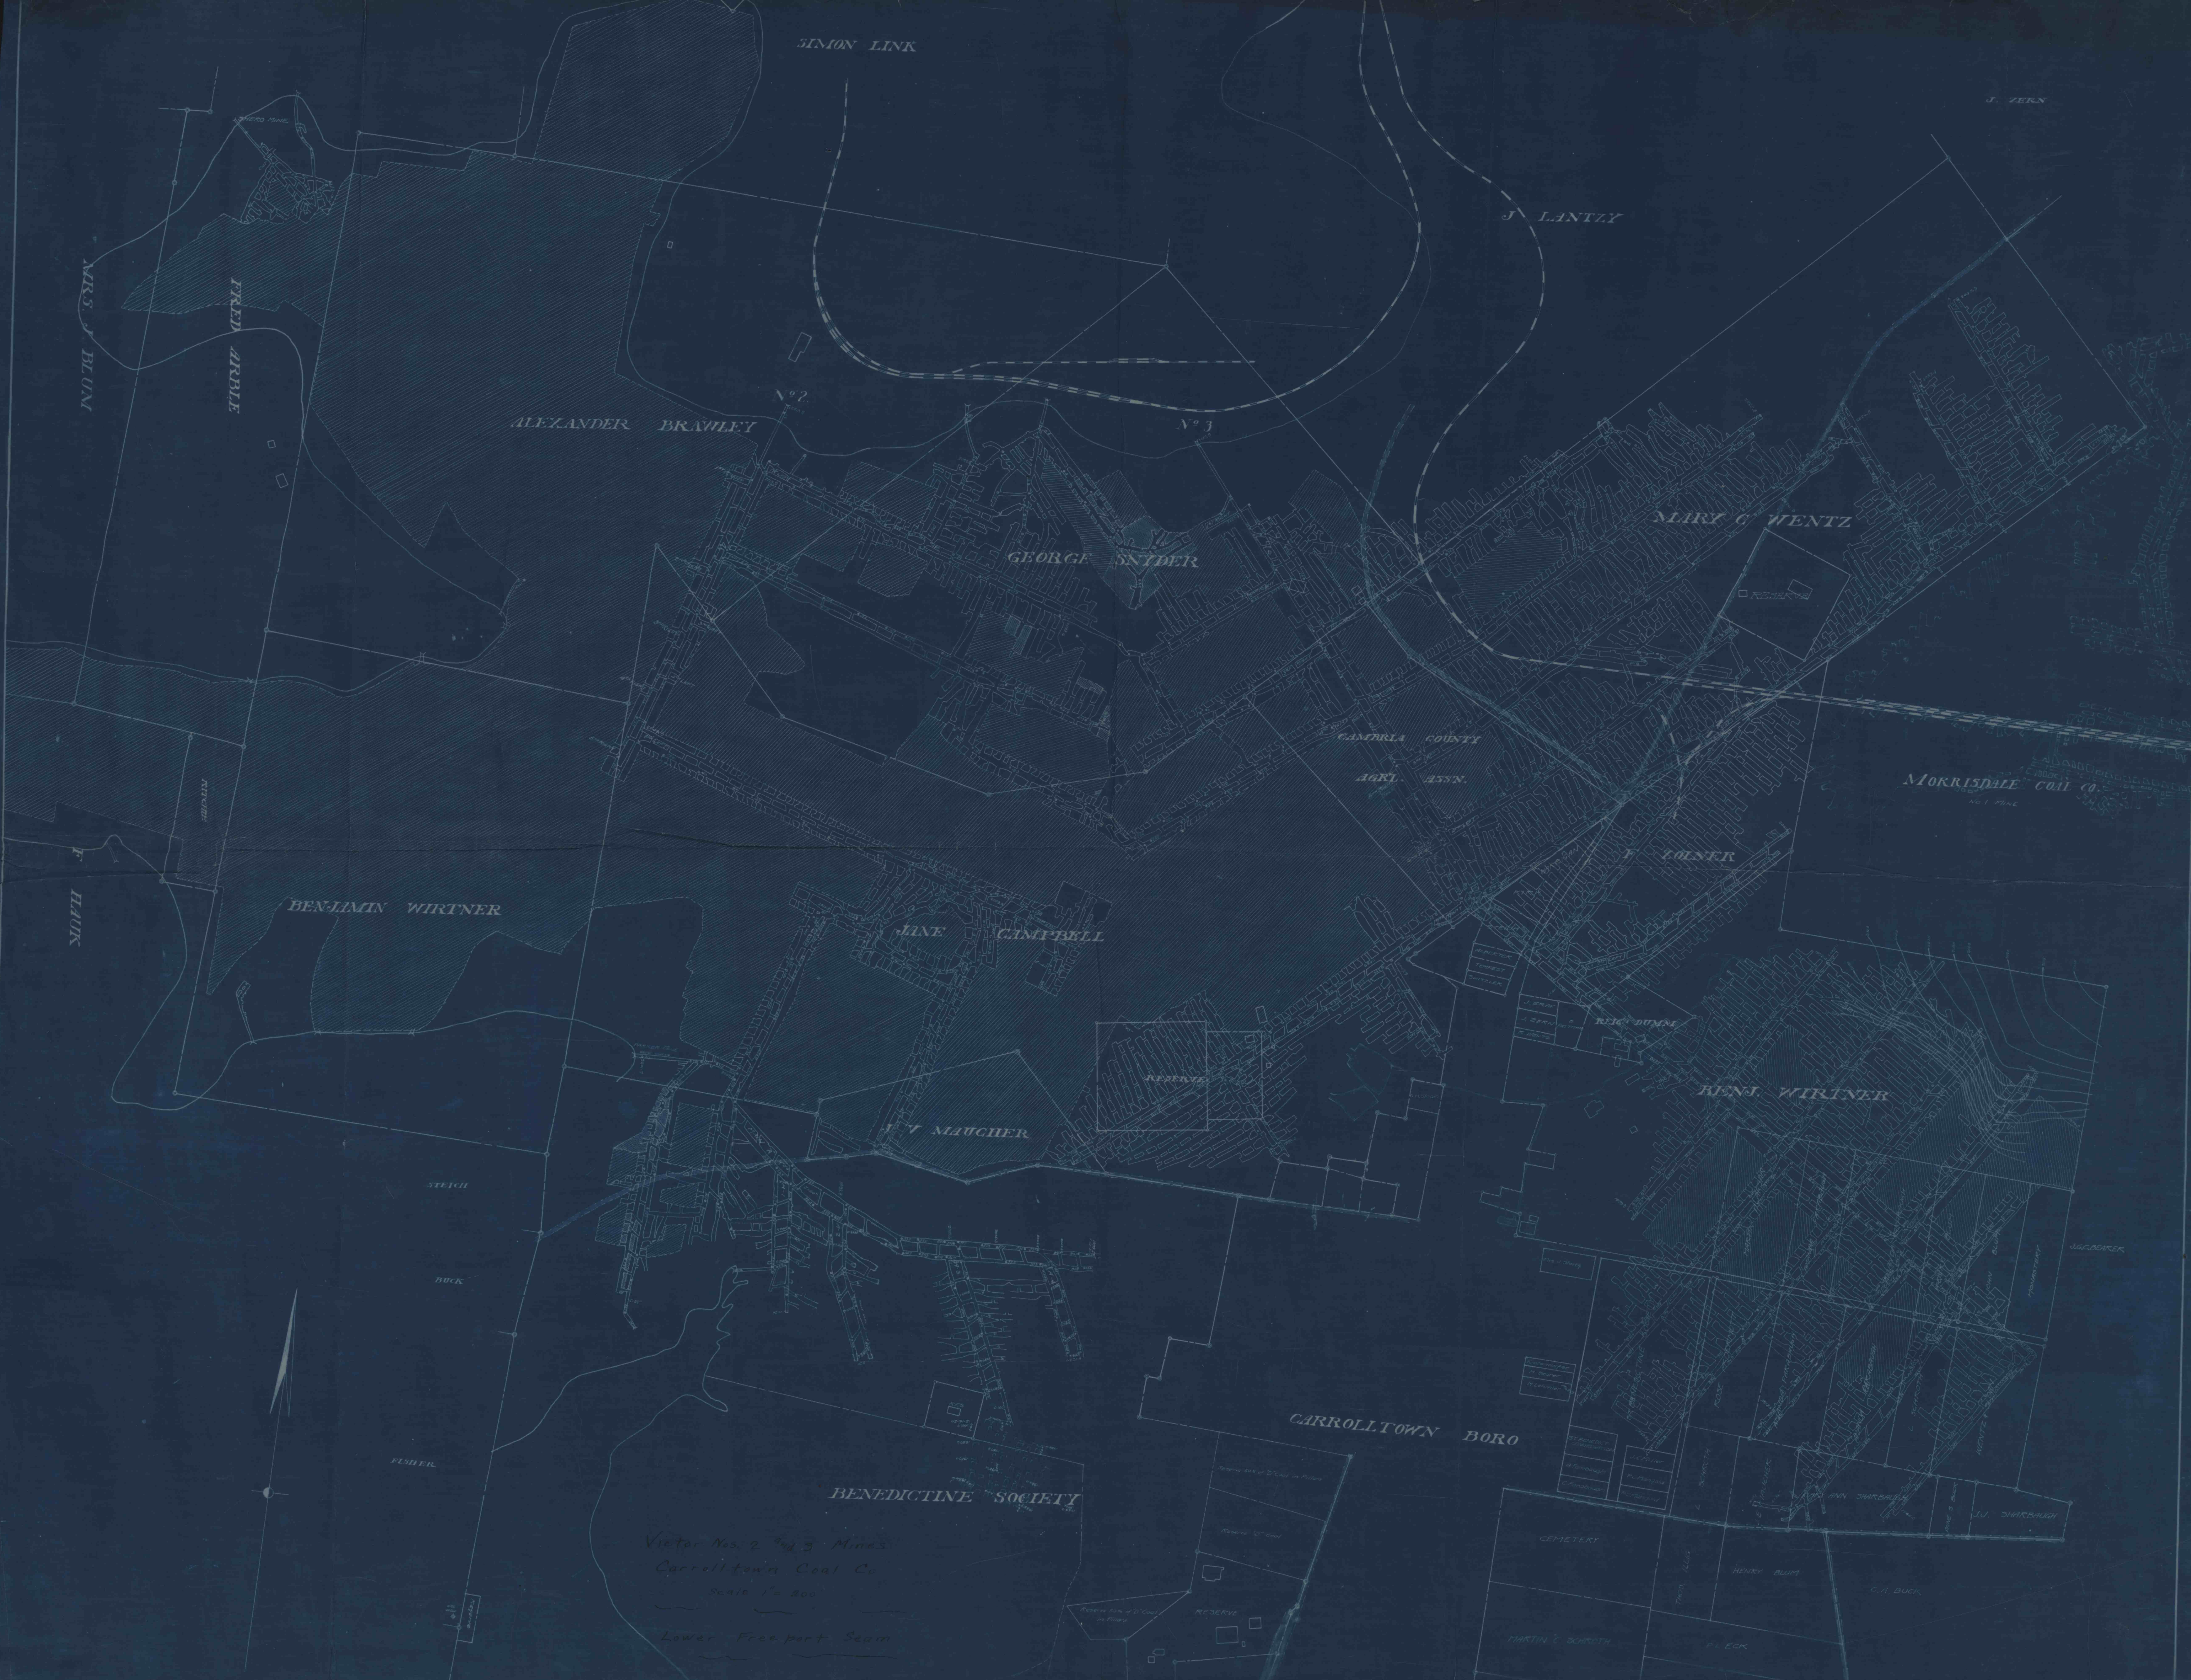
SIMON LINK
J. ZERN
J LANTZY
MRS. J BLUM
FRED ARBLE
ALEXANDER BRAWLEY
No 2
No 3
GEORGE SNYDER
MARY C WENTZ
RESERVE
CAMBRIA COUNTY
AGRL. ASSN.
MORRISDALE COAL CO.
No.1 MINE
F ZOLNER
F HAUK
RITCHIE
BENJAMIN WIRTNER
JANE CAMPBELL
J V MAUCHER
RESERVE
ALBERTER
TEMPEST
SWITZLER
J. GRAY
J. ZERN ESTATE
R. WENTZ
REIG & DUMM
BENJ. WIRTNER
J.G.C. BEARER
MONASTERY
STEICH
BUCK
FISHER
BENEDICTINE SOCIETY
CARROLLTOWN BORO
Reserve 50% of "D" Coal in Pillars
Reserve "D" Coal
Reserve 50% of "D" Coal in Pillars
RESERVE
ST. BENEDICT CONGREGATION
A. Farabaugh
C. Farabaugh
J.C. Miller
ANN SHARBAUGH
J.J. SHARBAUGH
CEMETERY
HENRY BLUM
C.A. BUCK
MARTIN C. SCHROTH
P.L. ECK
Victor Nos. 2 and 3 Mines
Carrolltown Coal Co
Scale 1" = 200
Lower Freeport Seam