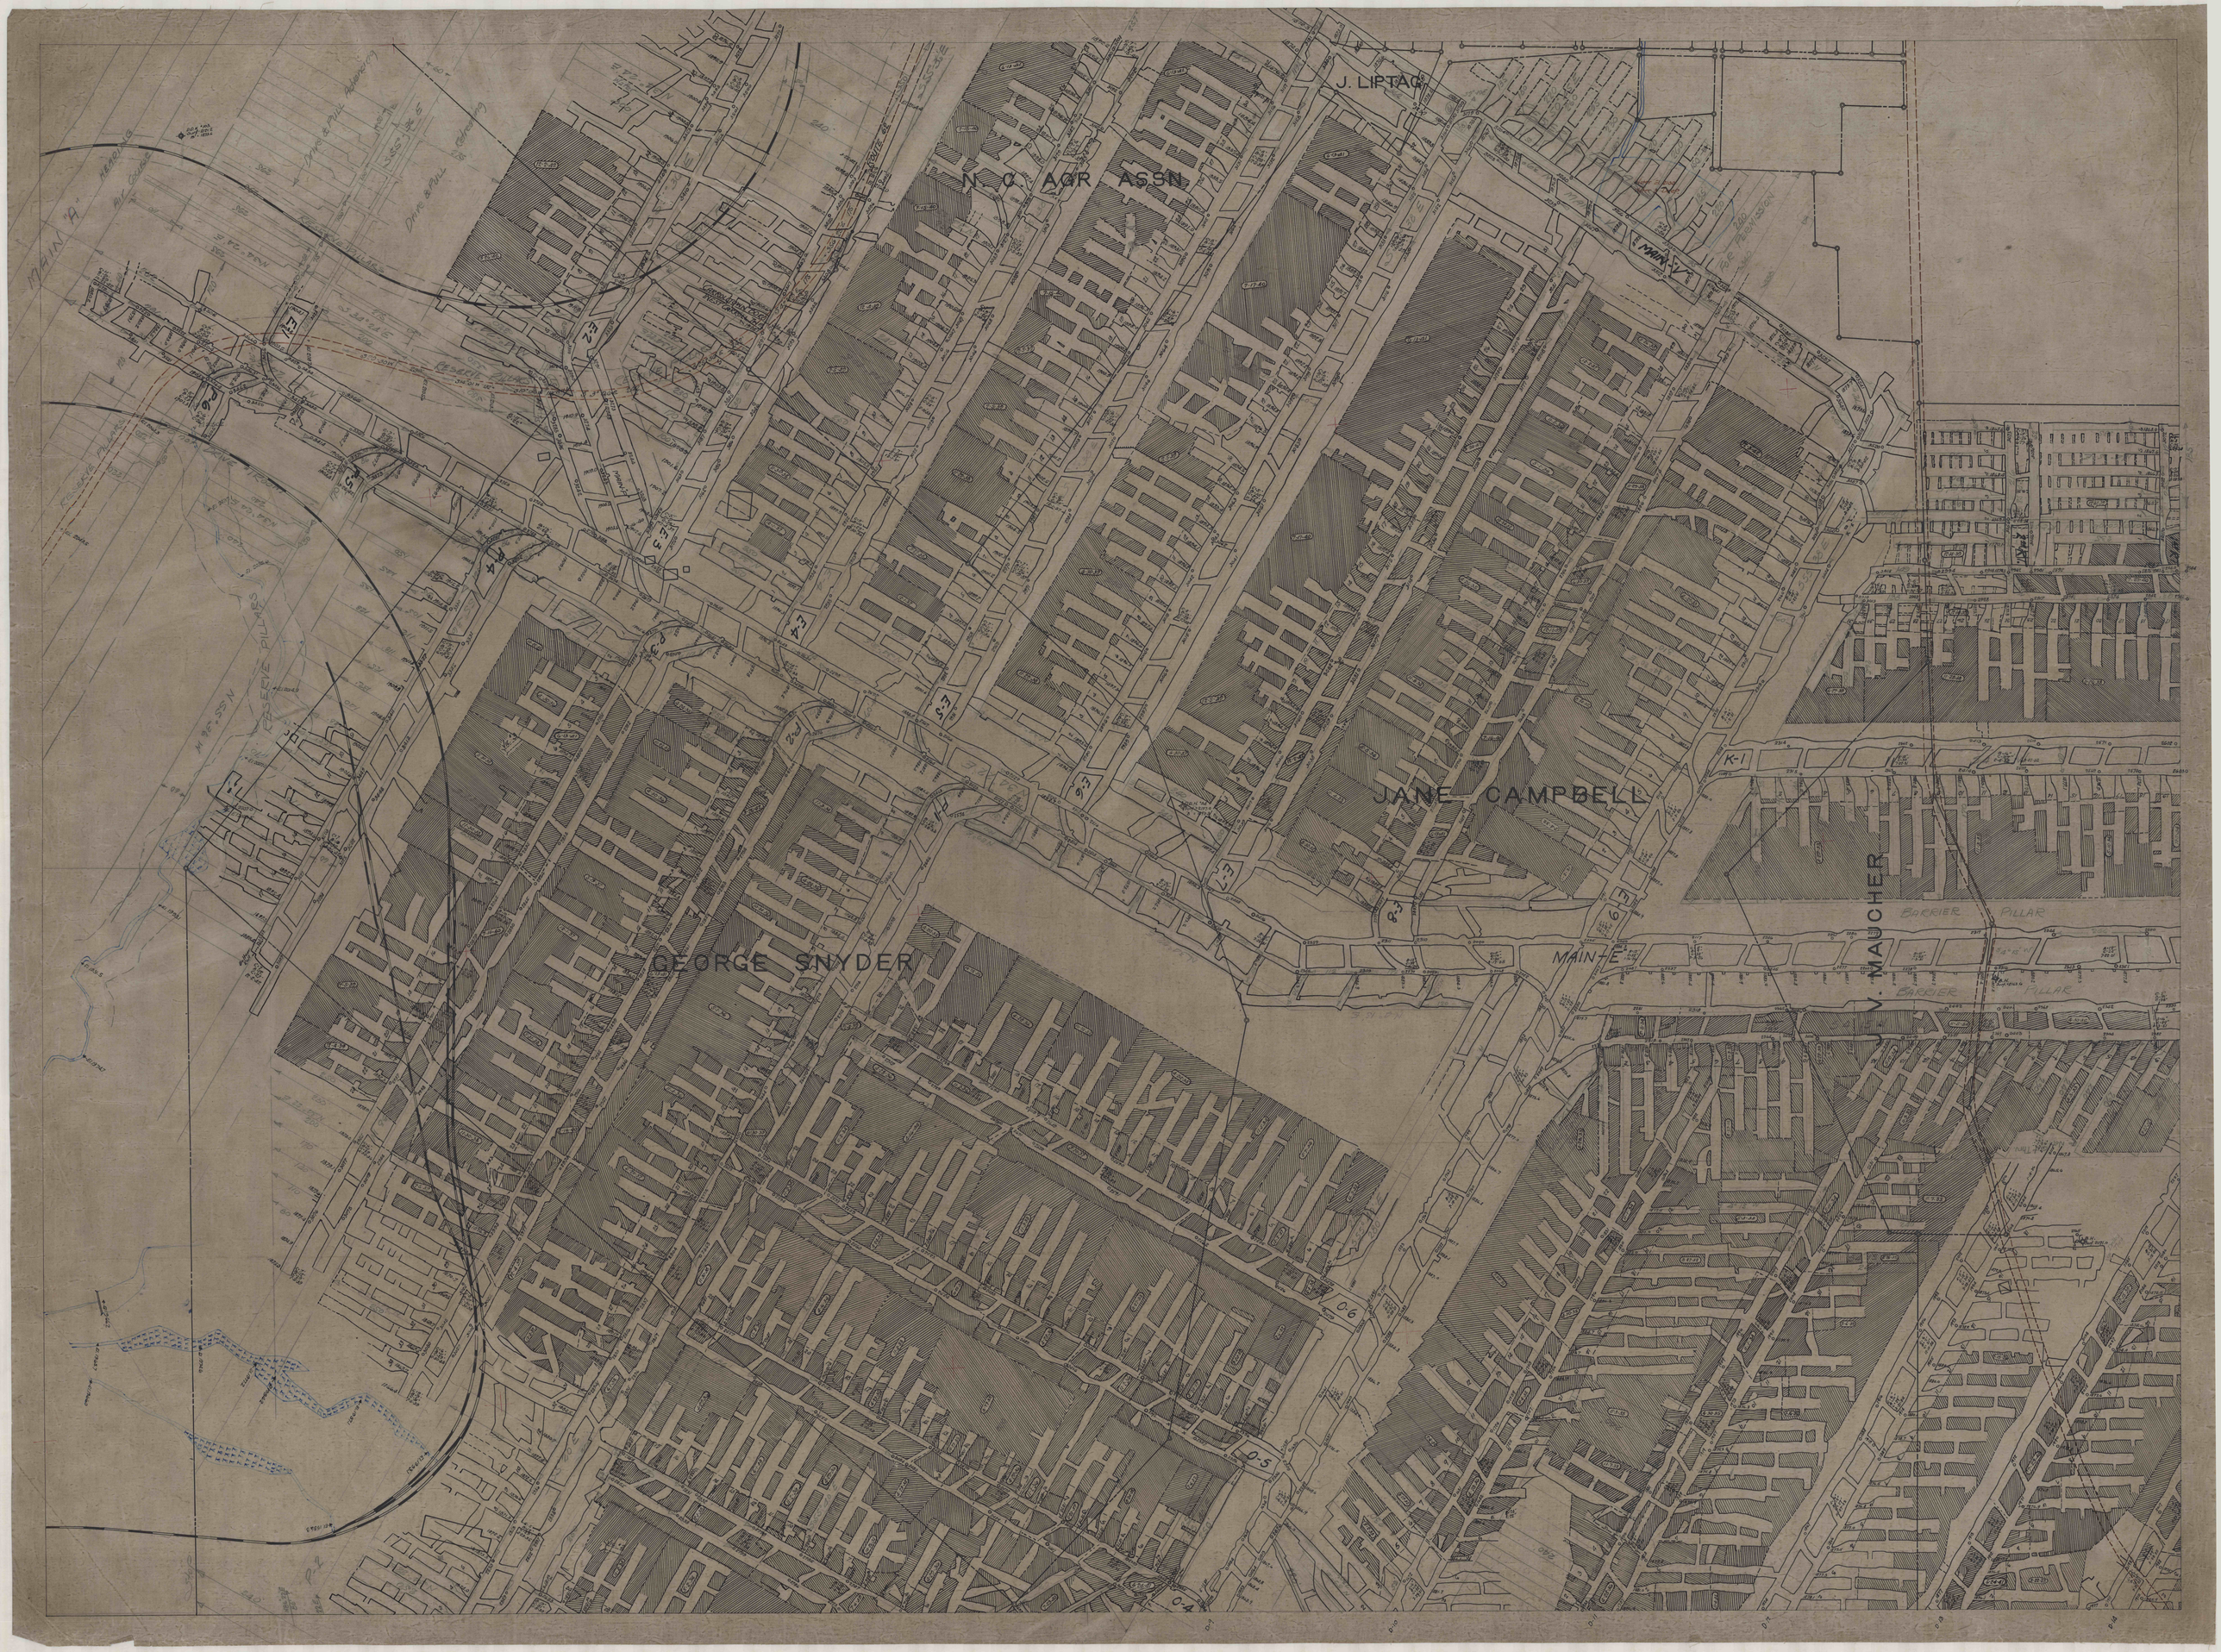
J. LIPTAG
N. C. AGR. ASSN.
JANE CAMPBELL
GEORGE SNYDER
MAIN-E
MAIN-V
V. MAUCHER
BARRIER PILLAR
BARRIER PILLAR
K-1
MAIN "A"
RESERVE PILLARS
RESERVE PILLARS
DRIVE & PULL
DRIVE & PULL
E-1
E-2
E-3
E-4
E-5
E-6
E-7
P-2
P-3
P-4
P-5
P-6
O-4
O-5
O-6