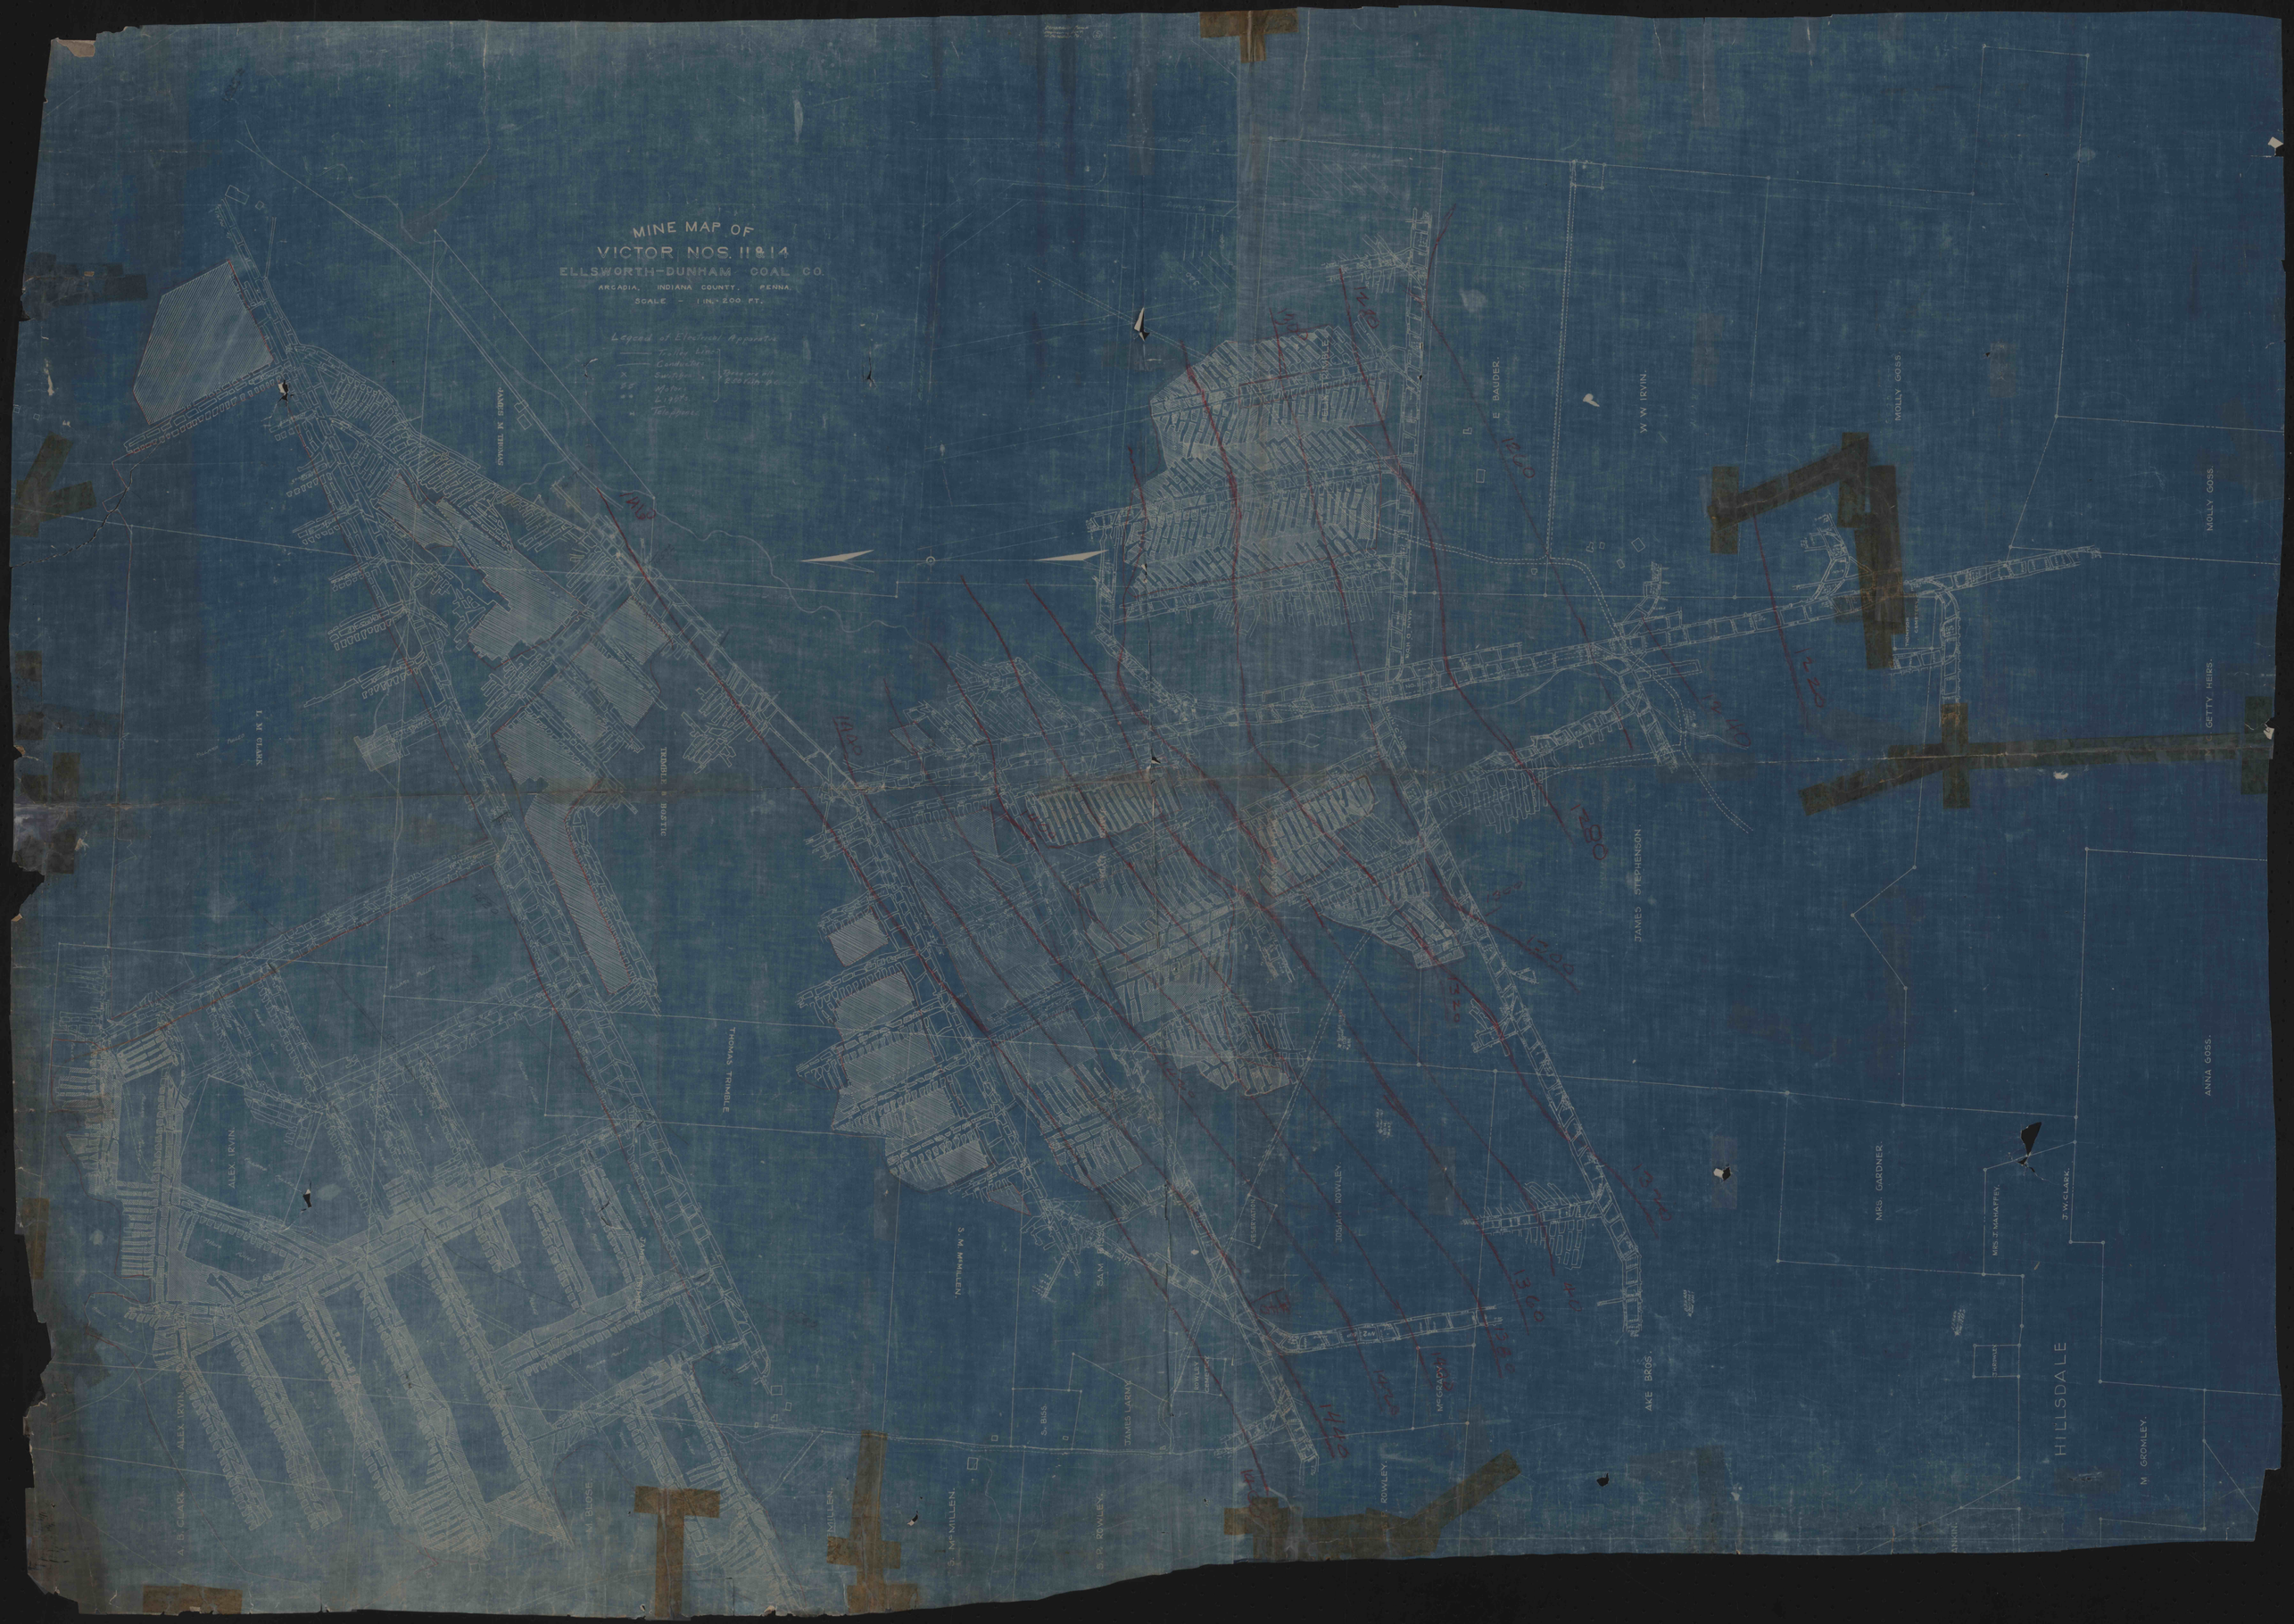
MINE MAP OF
VICTOR NOS. 11 & 14
ELLSWORTH-DUNHAM COAL CO.
ARCADIA, INDIANA COUNTY, PENNA.
SCALE - 1 IN. = 200 FT.
Legend of Electrical Apparatus
Trolley Lines
Conductors
Switches
Motors
Lights
Telephones
Drawn into all 250 Volts
JAMES M. THOMAS
THOMAS TRIMBLE
L. M. CLARK
ALEX. IRVIN
A. B. CLARK
M. BLOSE
S. McMILLEN
S. P. ROWLEY
JAMES LARMY
JOSIAH ROWLEY
McGRADY
AKE BROS.
JAMES STEPHENSON
MRS. GARDNER
MRS. J. MAHAFFEY
J. W. CLARK
ANNA GOSS
HILLSDALE
M. GROMLEY
MOLLY GOSS
GETTY HEIRS
W. W. IRVIN
E. BAUDER
1400
1300
1200
1100
1000
900
800
700
600
500
400
300
200
100