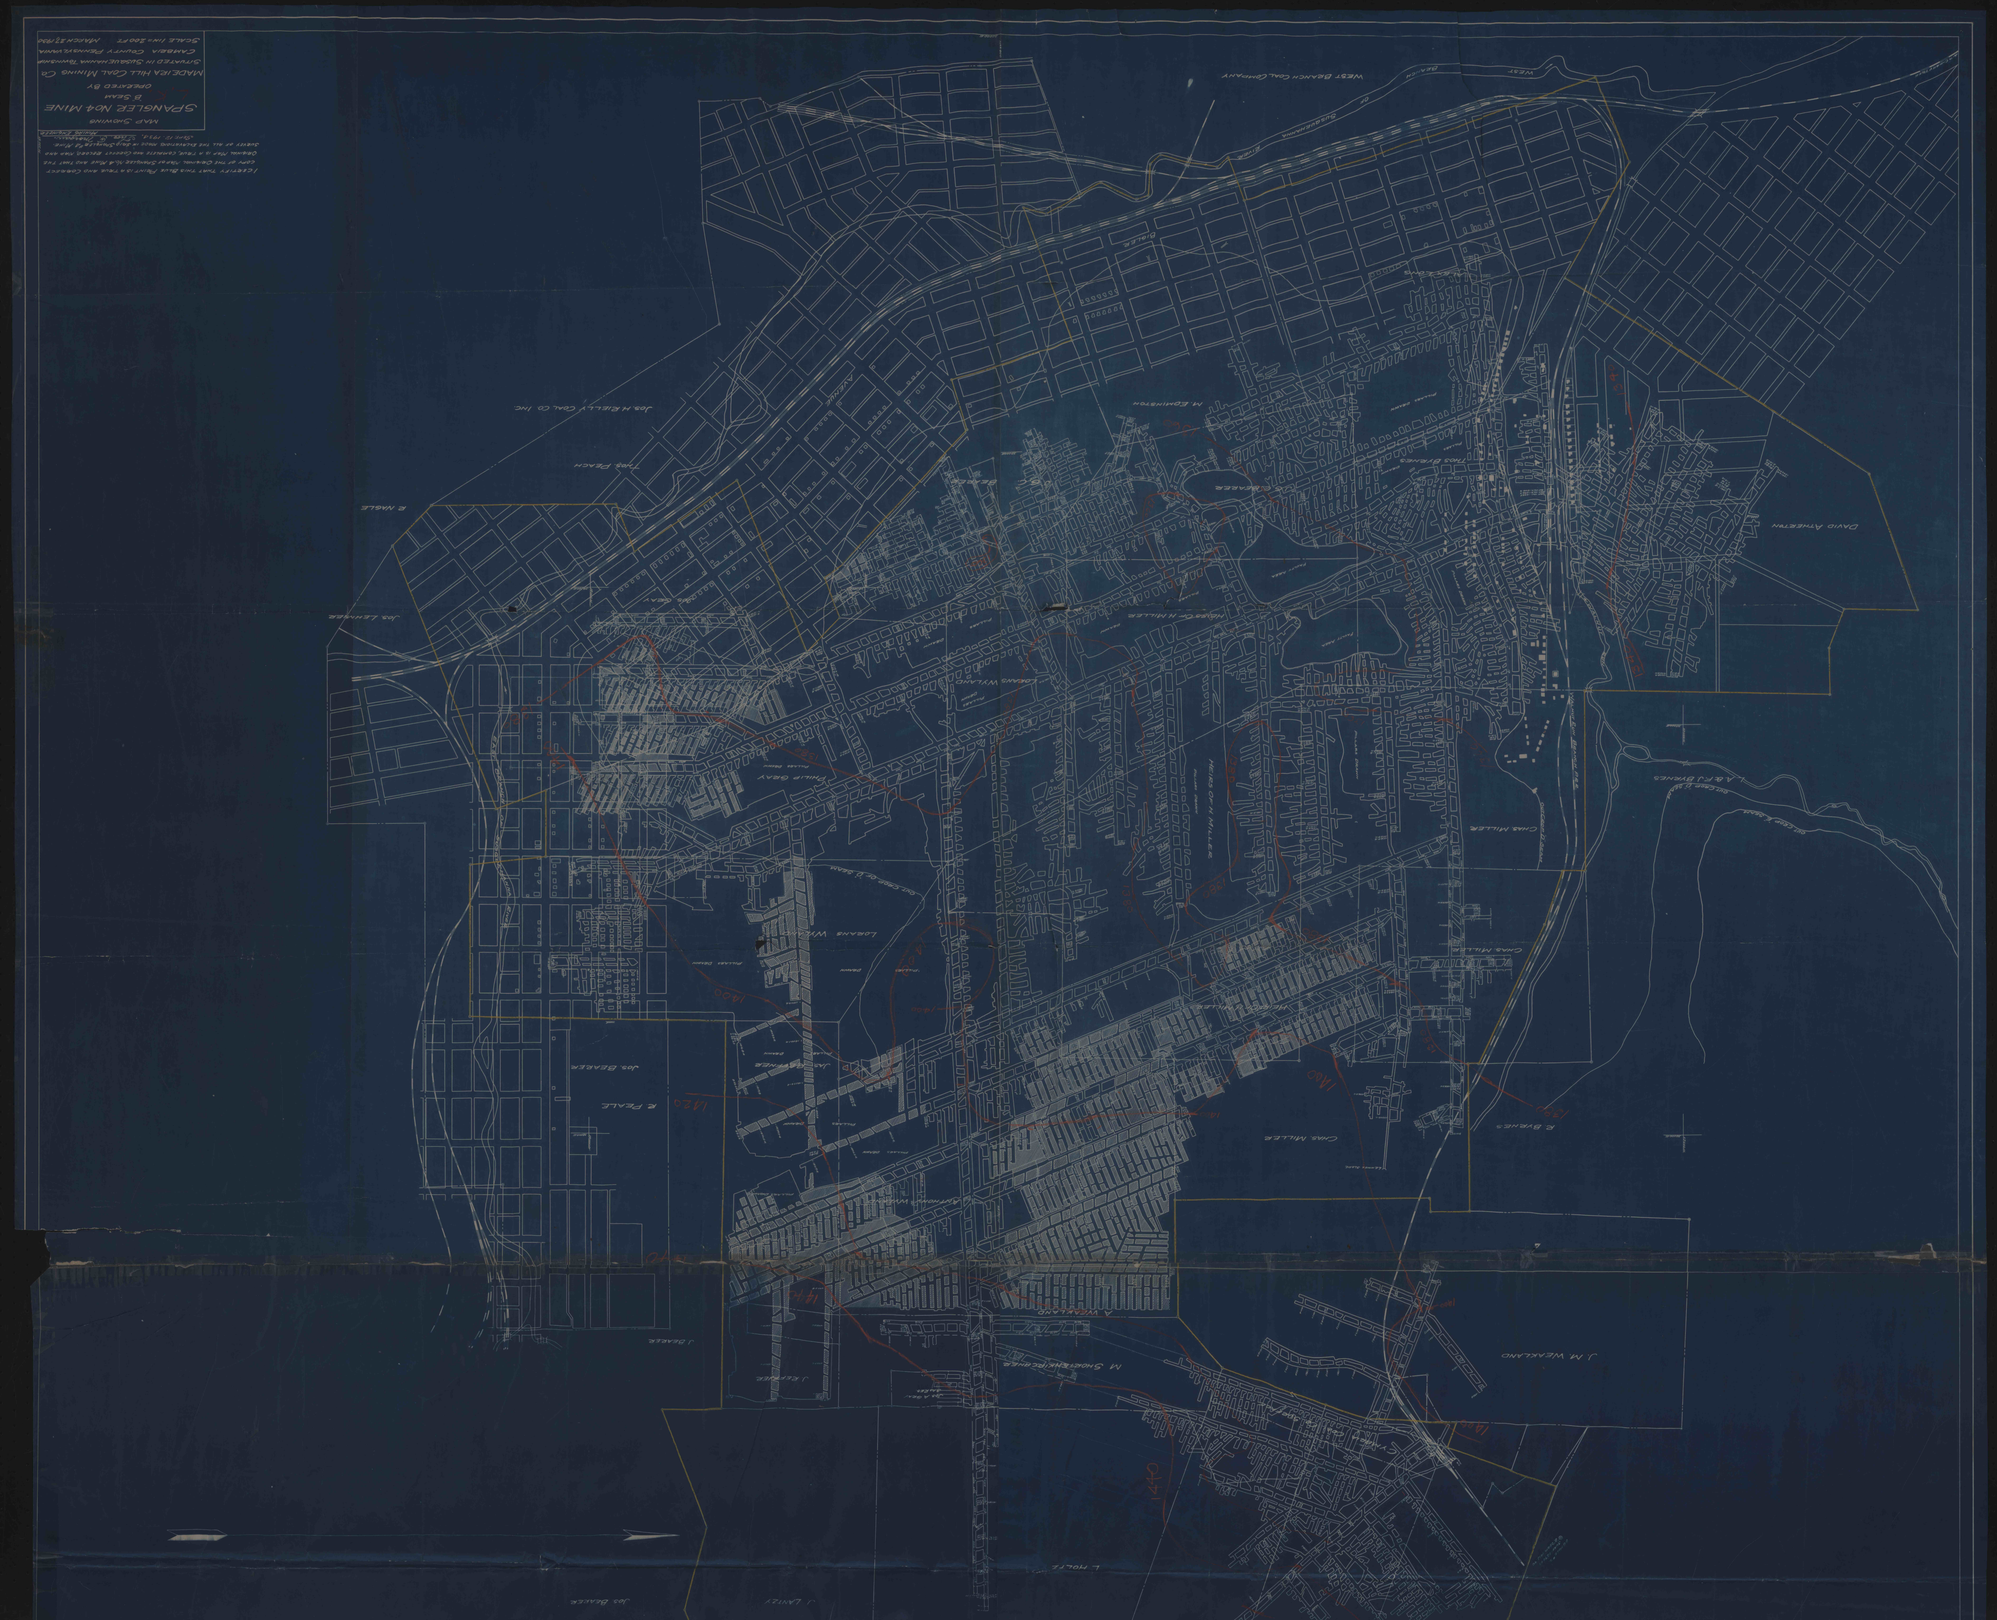

MAP SHOWING
SPANGLER No4 MINE
8 SEAM
OPERATED BY
MADEIRA HILL COAL MINING CO
SITUATED IN SUGAREMANNA TOWNSHIP
CAMBRIA COUNTY PENNSYLVANIA
SCALE 1IN=200FT MARCH 27, 1920
I CERTIFY THAT THIS BLUE PRINT IS A TRUE AND CORRECT COPY OF THE ORIGINAL PAPER SPANGLER No.4 MINE AND THAT THE ORIGINAL PAPER IS A TRUE COMPUTER AND CORRECT EXCESS AND ANY SURVEY OF ALL THE ENGINEERING MADE IN THE SPANGLER No.4 MINE.
SEPT. 17, 1914. STAR C. PARSONS
WEST BRANCH COAL COMPANY
DAVID ATHERTON
CHAS. MILLER
J. M. WEAKLAND