


SPRINGFIELD #4 MINE
SPRINGFIELD COAL CORP.
SCALE 1"=500'
BARNES & TUCKER CO.

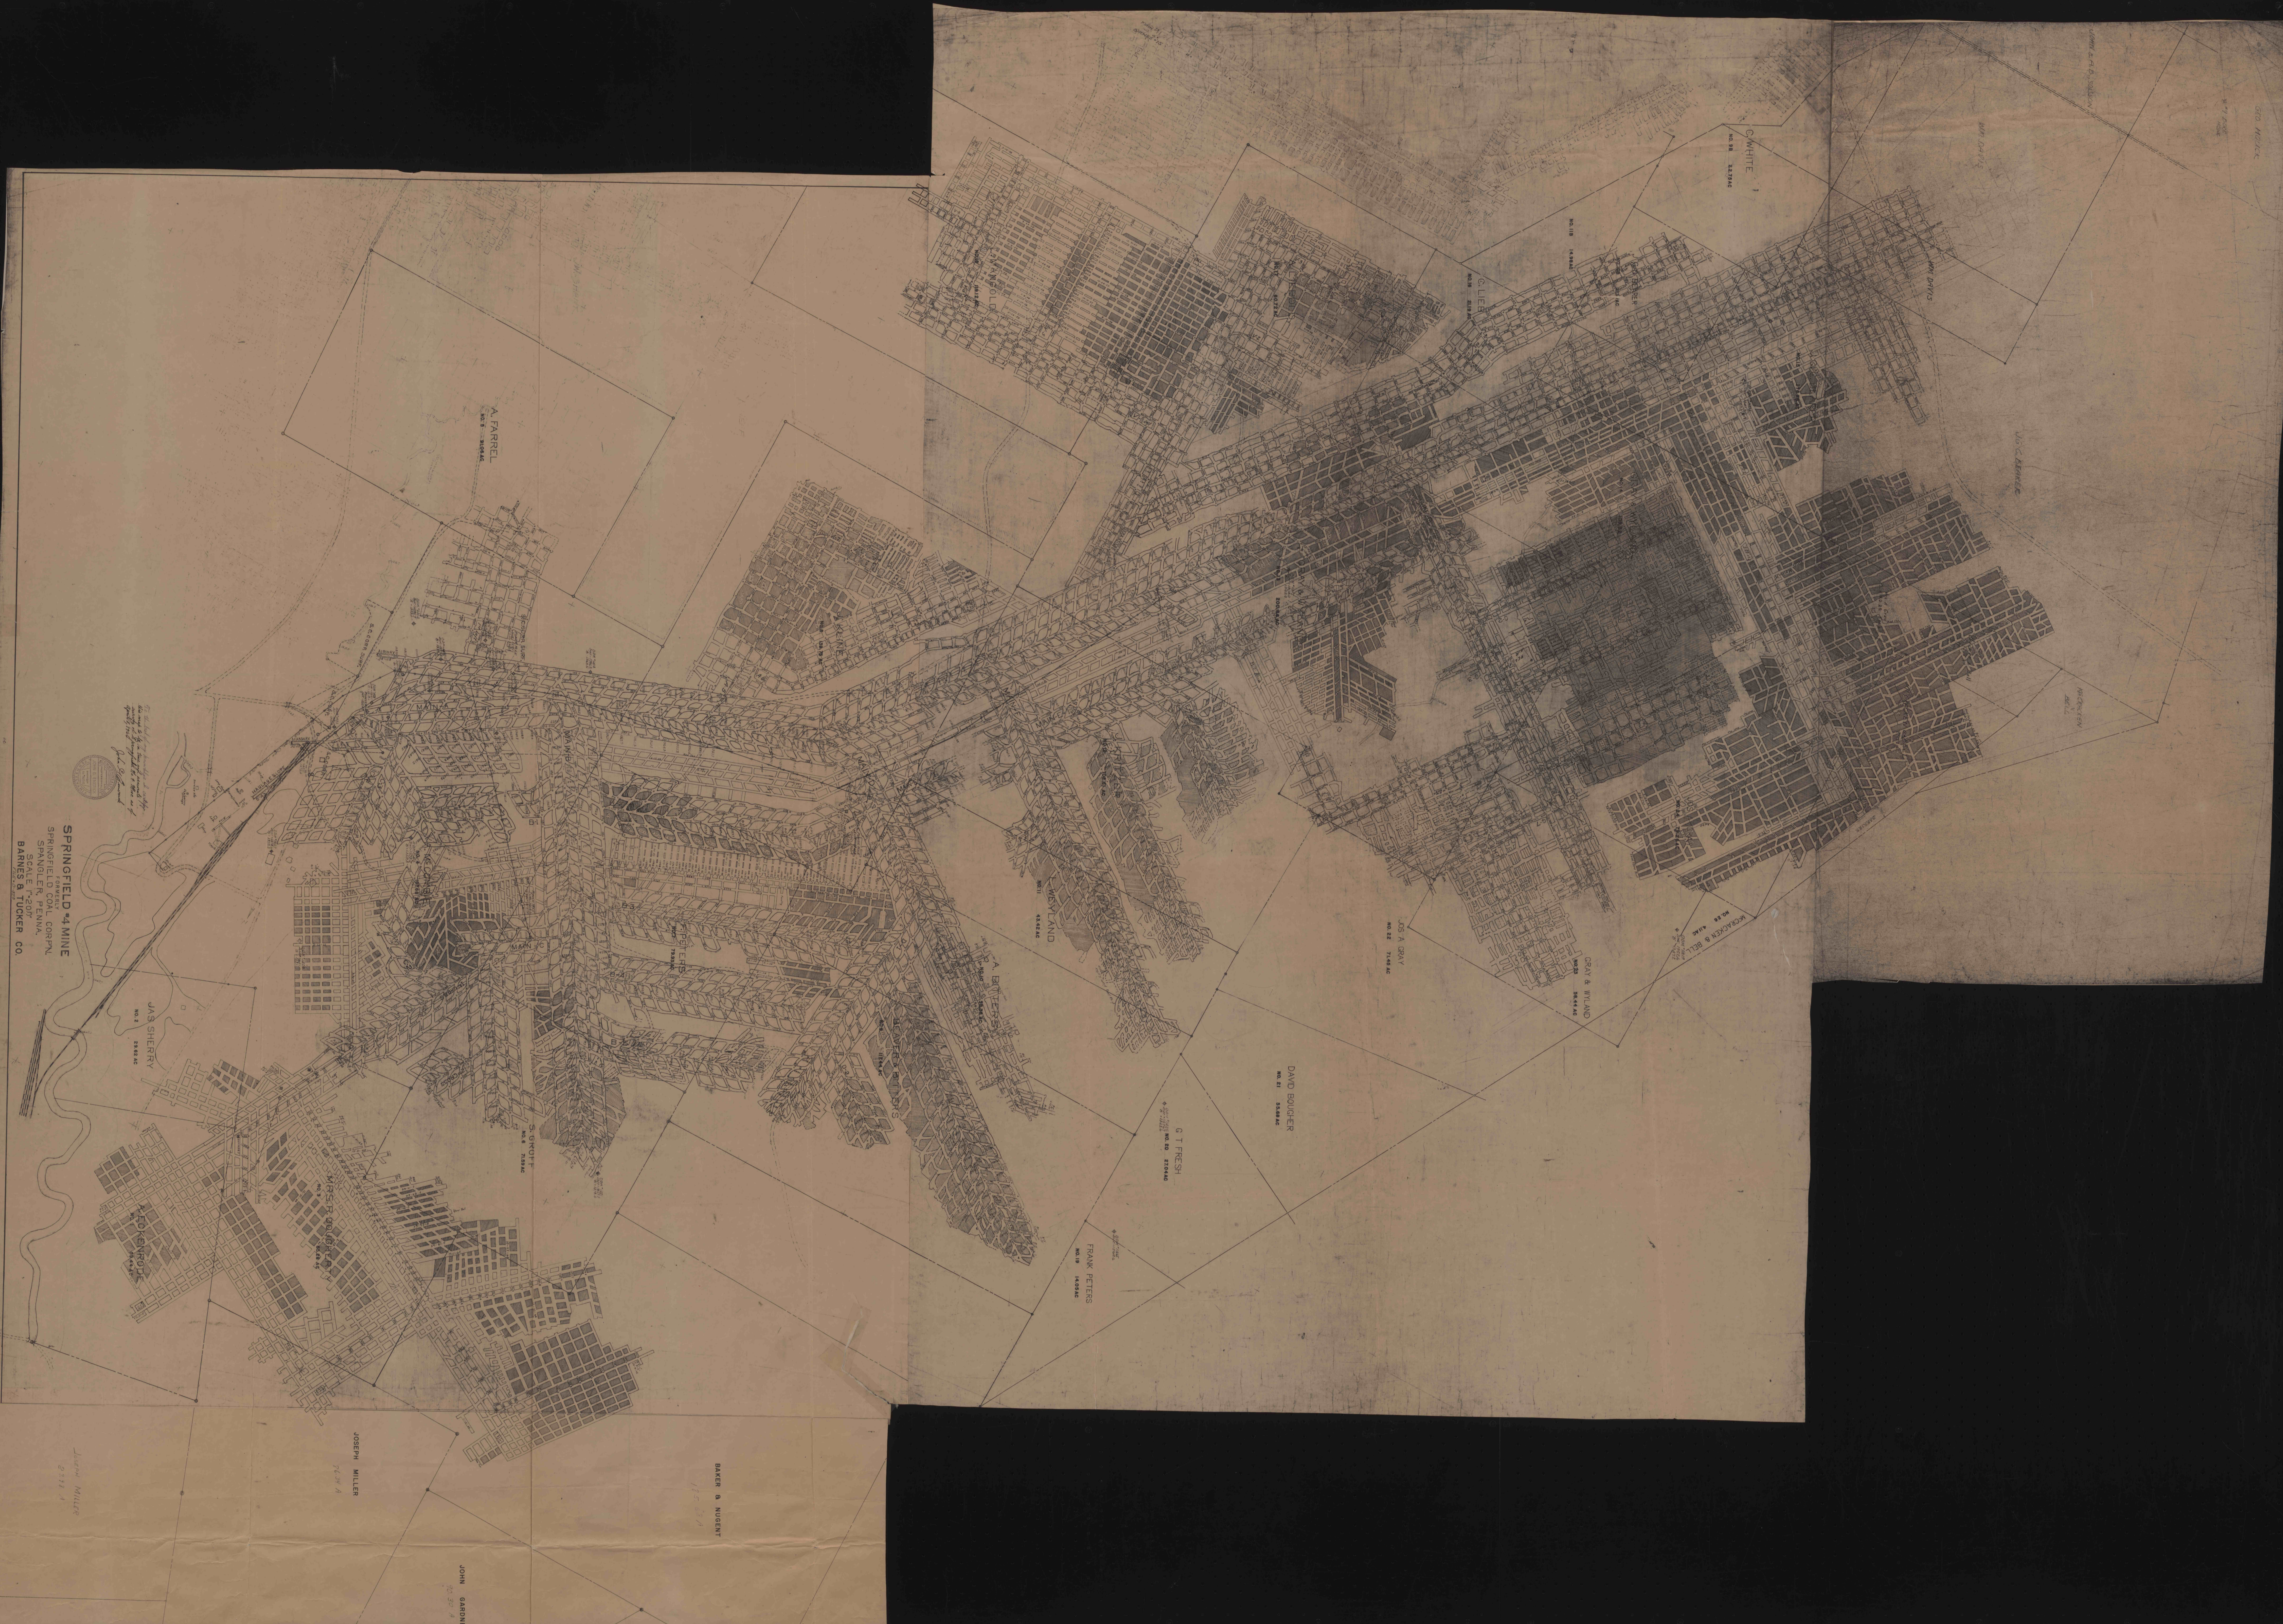













