


SPRINGFIELD #4 MINE
SPRINGFIELD COAL CORP.
SPRINGFIELD, PENNA.
SCALE 1" = 200'
BARNES & TUCKER CO.

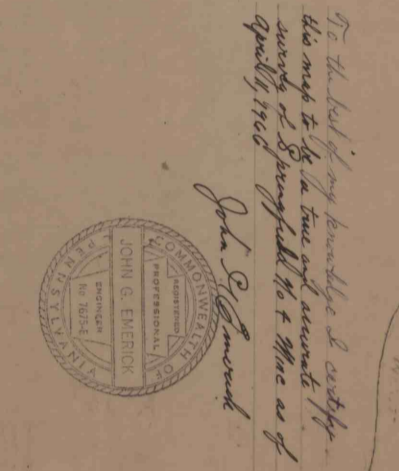




















