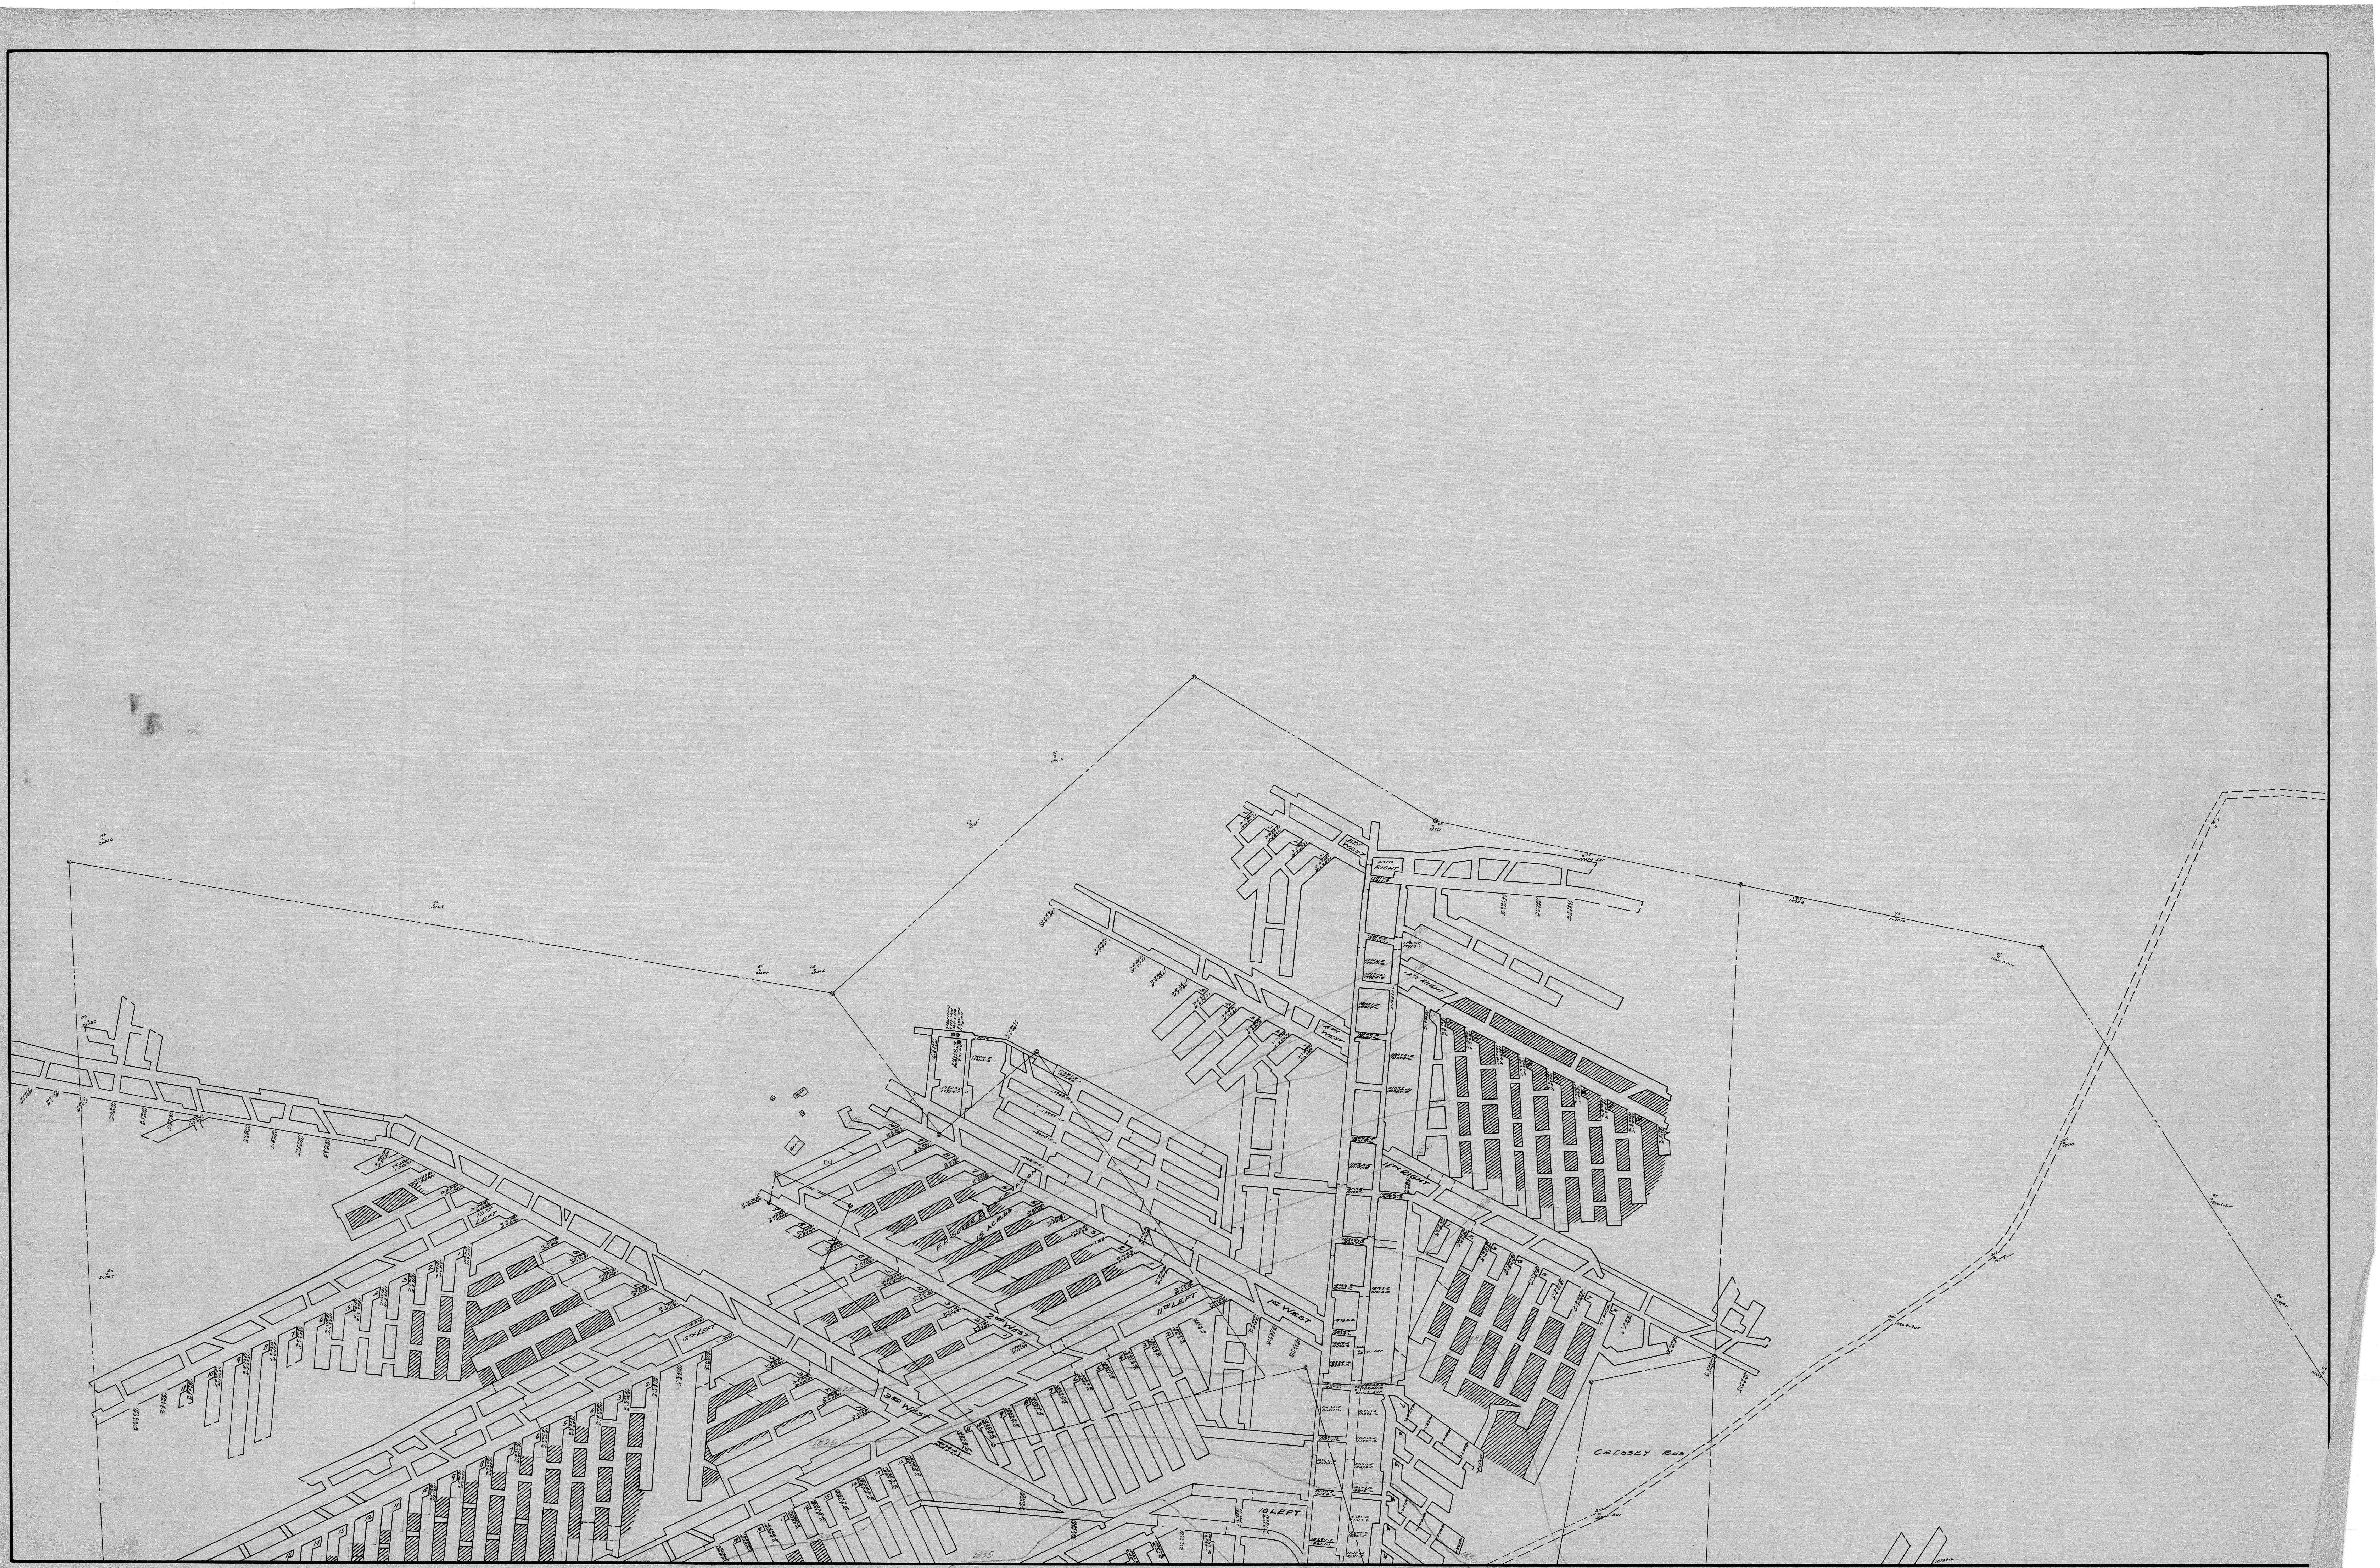
5TH WEST
13TH RIGHT
12TH RIGHT
4TH WEST
11TH RIGHT
1ST. WEST
11TH LEFT
2ND WEST
3RD WEST
10 LEFT
13TH LEFT
12TH LEFT
F.R. SUTER RESERVATION
15 ACRES
BARN
CRESSEY RES
1820
1825
1830
1835