




SURVEY EXTENDED  
TO 19

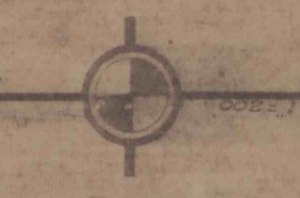

- LEGEND**
- ACTUAL GAS WELL
  - ABANDONED GAS WELL
  - ACTIVE OIL WELL
  - ABANDONED OIL WELL
  - PRODUCTION LINES
  - STRAIGHT
  - DISCONTINUED SECTION OF ROAD

MINE CLOSED 12-23-14  
 POSTED  
 1911896  
 WILKESBARRE MINE  
 12-23-14

