


BENEDICTINE SOCIETY - SURFACE  
LATROBE COAL CO. COAL

ELEV. TOP. 1009' DEPTH 1538'  
AIR SHAFT. LATROBE COAL CO.  
SCALE 855'  
ELEV. WATER - MAY 15 1920 - 982.0  
" MAR 9 1928 - 938.0

NOTE:  
THE PARTY OF THE FIRST PART MAY RUN NOT TO EXCEED TWO PAIRS OF ENTRIES THROUGH RESERVATIONS A, B, C AND D ANY OR ALL OF THEM AS IN HIS JUDGEMENT MAY BE DEEMED NECESSARY IN THE SUCCESSFUL MINING AND REMOVING OF THE COAL CONVEYED IN THE DRAIN AND VENTILATING OF THE MINE. EACH ENTRY SHALL BE NO MORE THAN 10 FEET IN WIDTH AND THE ENTRIES SHALL BE SEPARATED BY AT LEAST FORTY FEET OF COAL PROVIDED HOWEVER THAT NO ENTRIES SHALL BE SO LOCATED AS TO PASS UNDER THE MAIN BUILDINGS ERECTED ON RESERVATION 'B'.

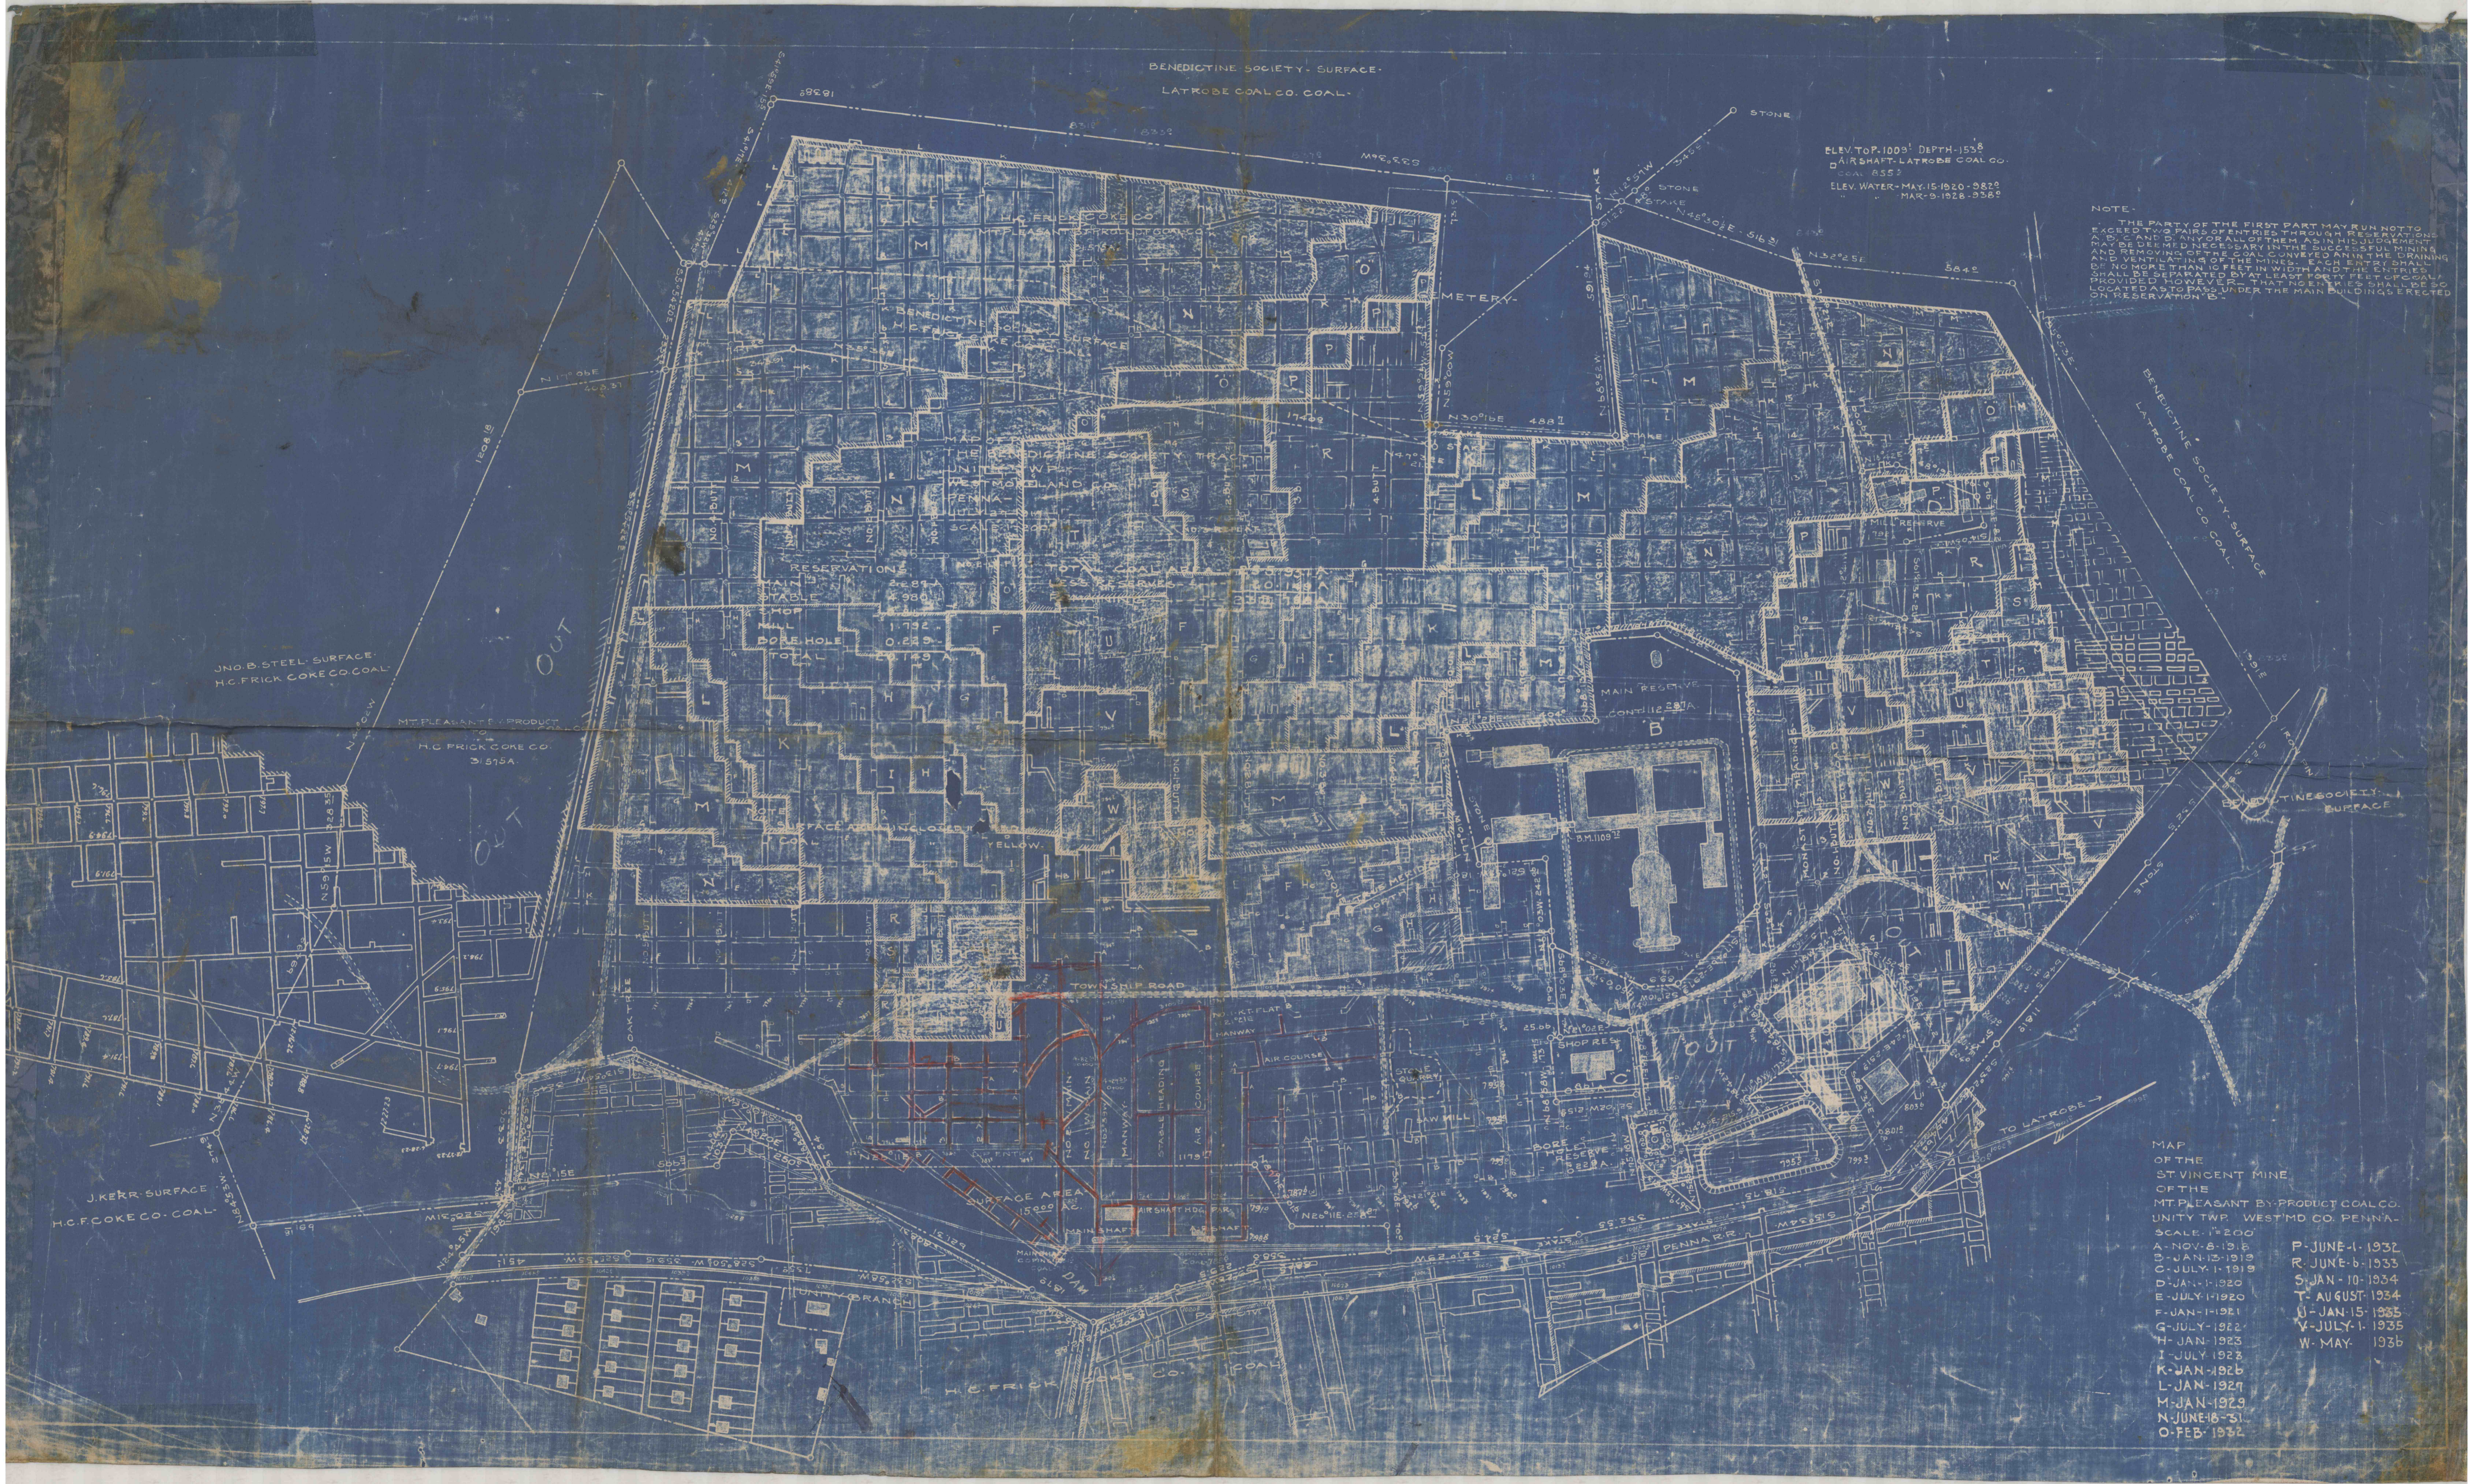

MAP OF THE ST VINCENT MINE OF THE MT PLEASANT BY-PRODUCT COAL CO. UNITY TWP. WEST MD CO. PENNA. SCALE 1"=200'

A - NOV. 8 1915	P - JUNE 1 1932
B - JAN. 13 1918	R - JUNE 6 1933
C - JULY 1 1919	S - JAN. 10 1934
D - JAN. 1 1920	T - AUGUST 1934
E - JULY 1 1920	U - JAN. 15 1935
F - JAN. 1 1921	V - JULY 1 1935
G - JULY 1 1921	W - MAY 1936
H - JAN. 1923	
I - JULY 1923	
K - JAN. 1926	
L - JAN. 1929	
M - JAN. 1929	
N - JUNE 16 '31	
O - FEB. 1932	