


COAL LANDS
operated by the
E. J. Walker Coal Co.
Scale 1" = 200' Oct. 1920
J.A. Zeigler Eng.

Wallace Reading & Ritchie

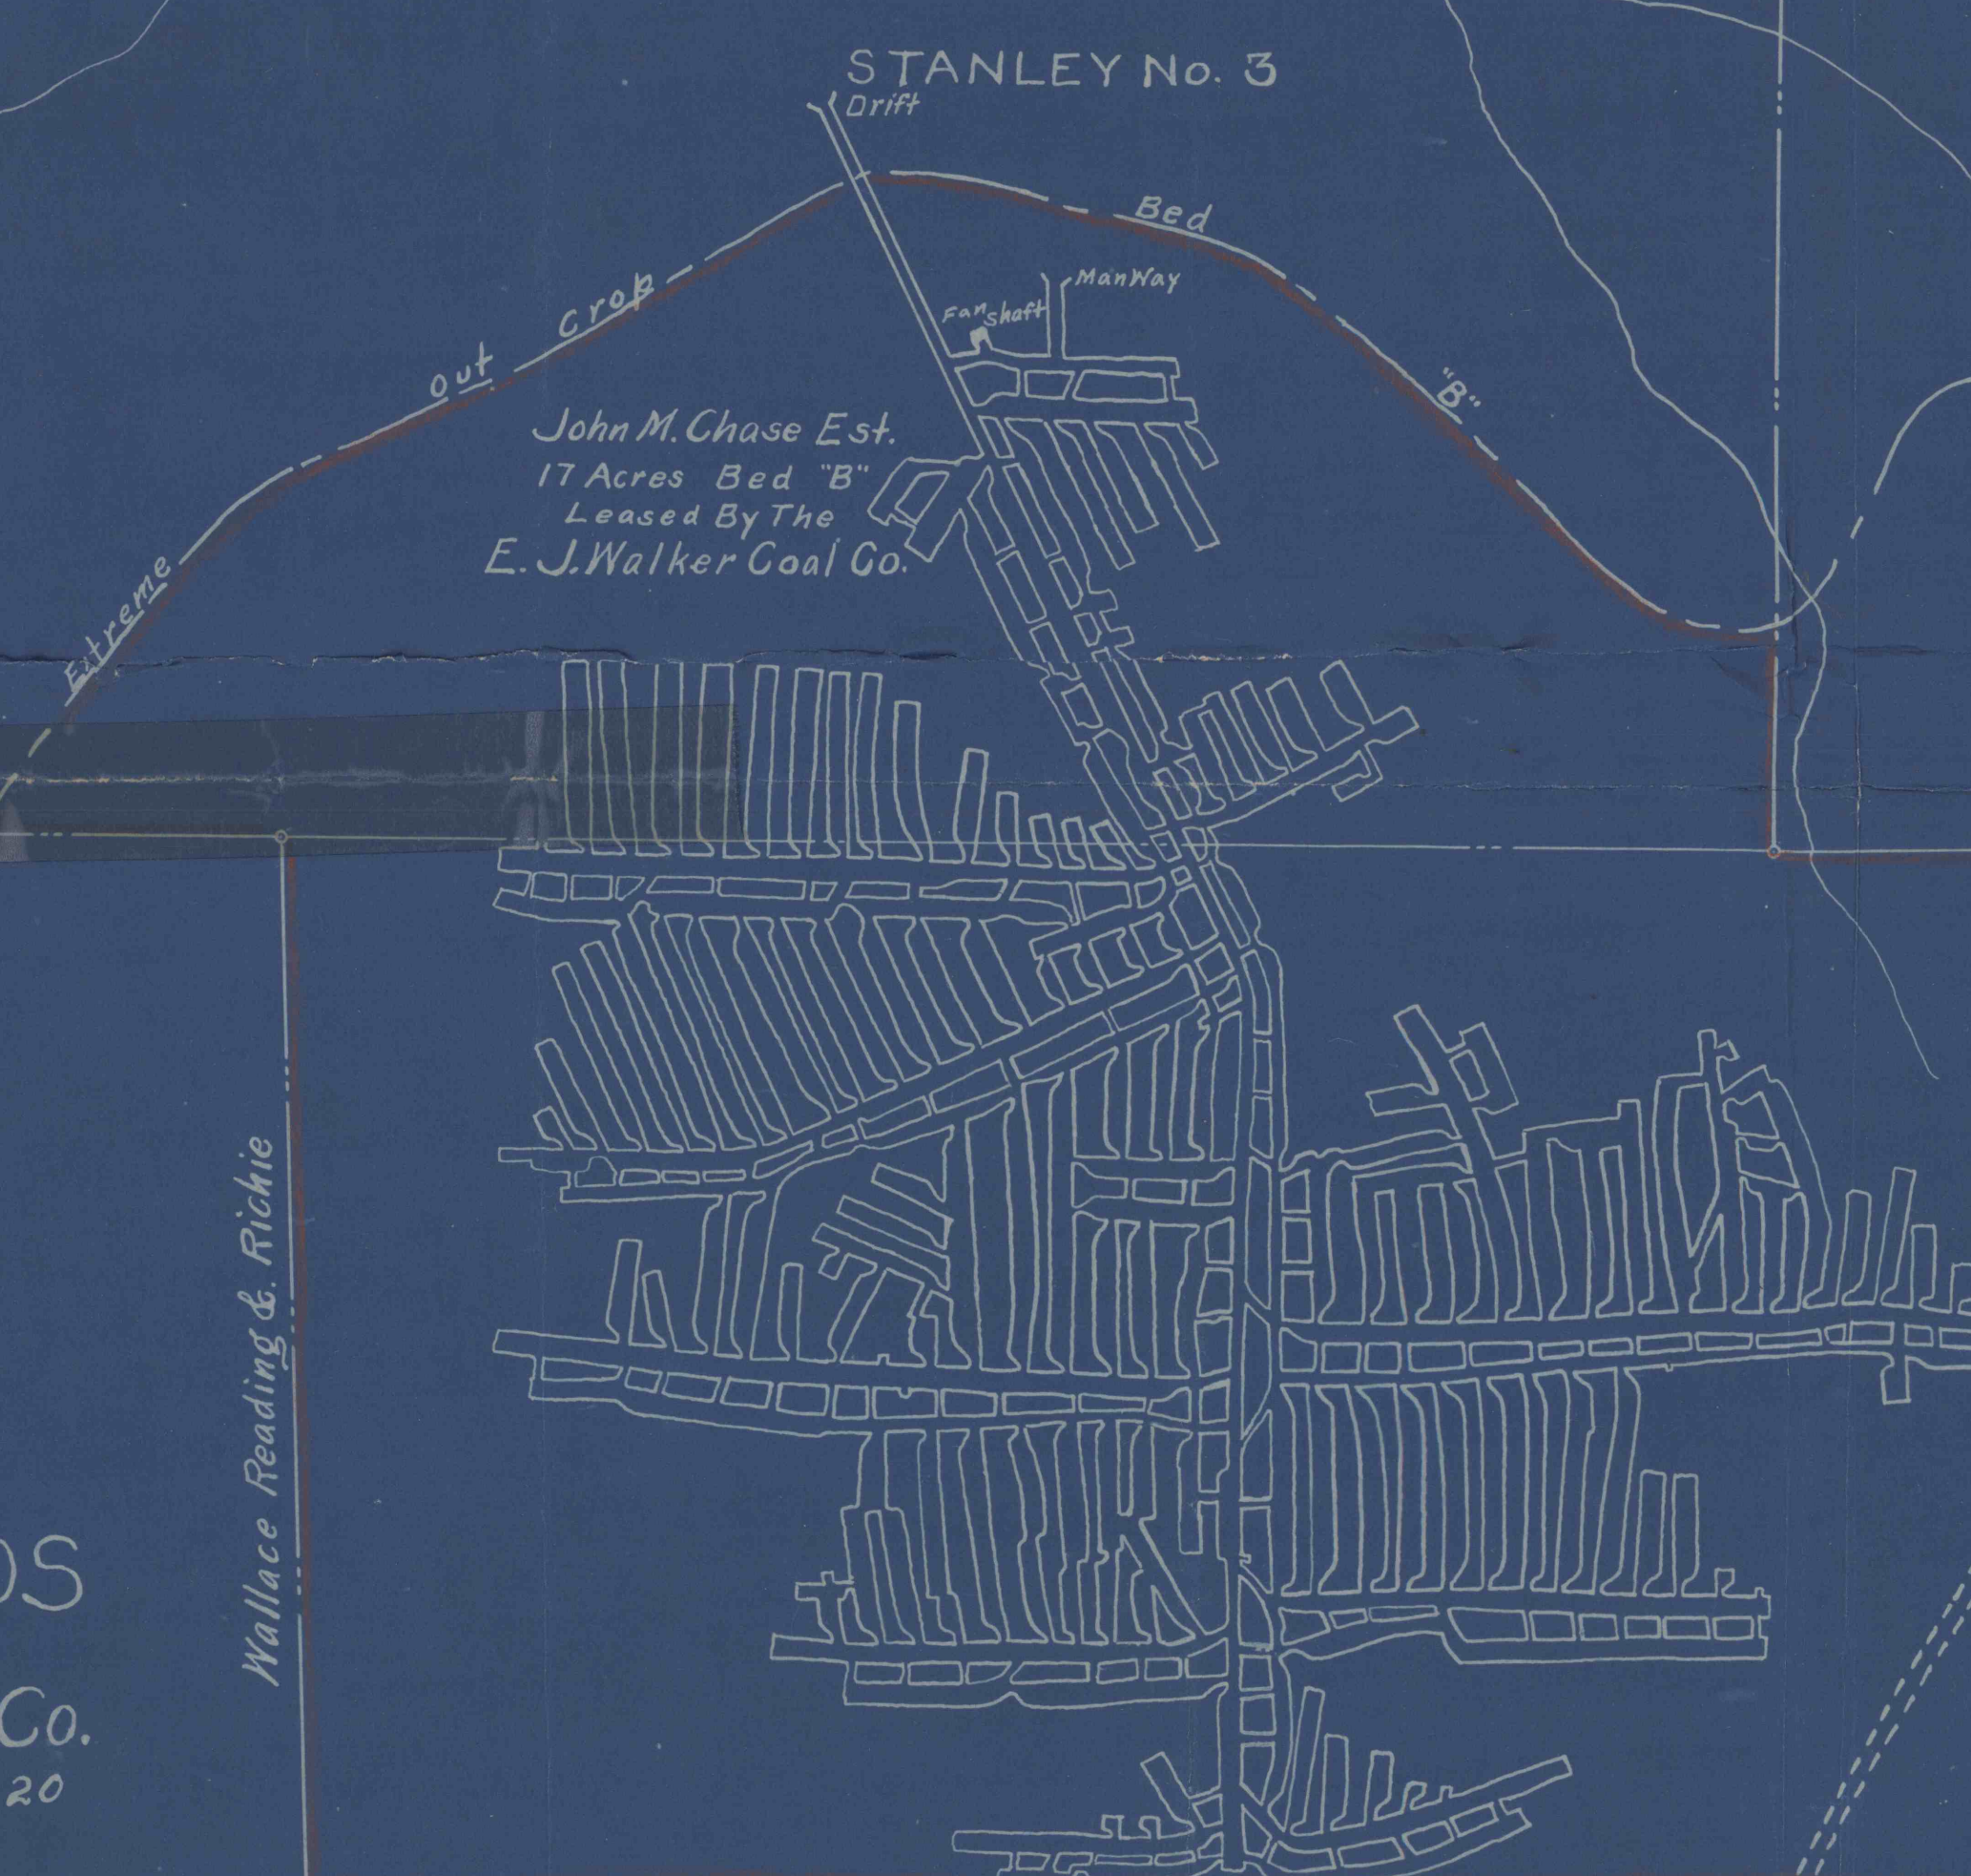

John M. Chase Est.
17 Acres Bed "B"
Leased By The
E. J. Walker Coal Co.

Berrind-White & Co. & H.G. Fisher Est.
80.5 Acres Bed "B"
Leased By The
E. J. Walker Coal Company

Berrind-White & Co. & H.G. Fisher Est.

E. E. Henderson

Berrind-White & Co. & H.G. Fisher Est.

Magnolia North

Morgan

Run

STANLEY No. 3

Bed

"B"

Tennsby

Road