


LEGEND

- PROPERTY LIMIT
- HOUSE NUMBER
- 6 MONTH ADVANCE
AUG. 1966 - FEB. 1967

NOTE - NO SUPPORT AREA IS SHOWN AS DUE TO NUMEROUS HOUSES ALL MINING IS LIMITED TO 50% RECOVERY.

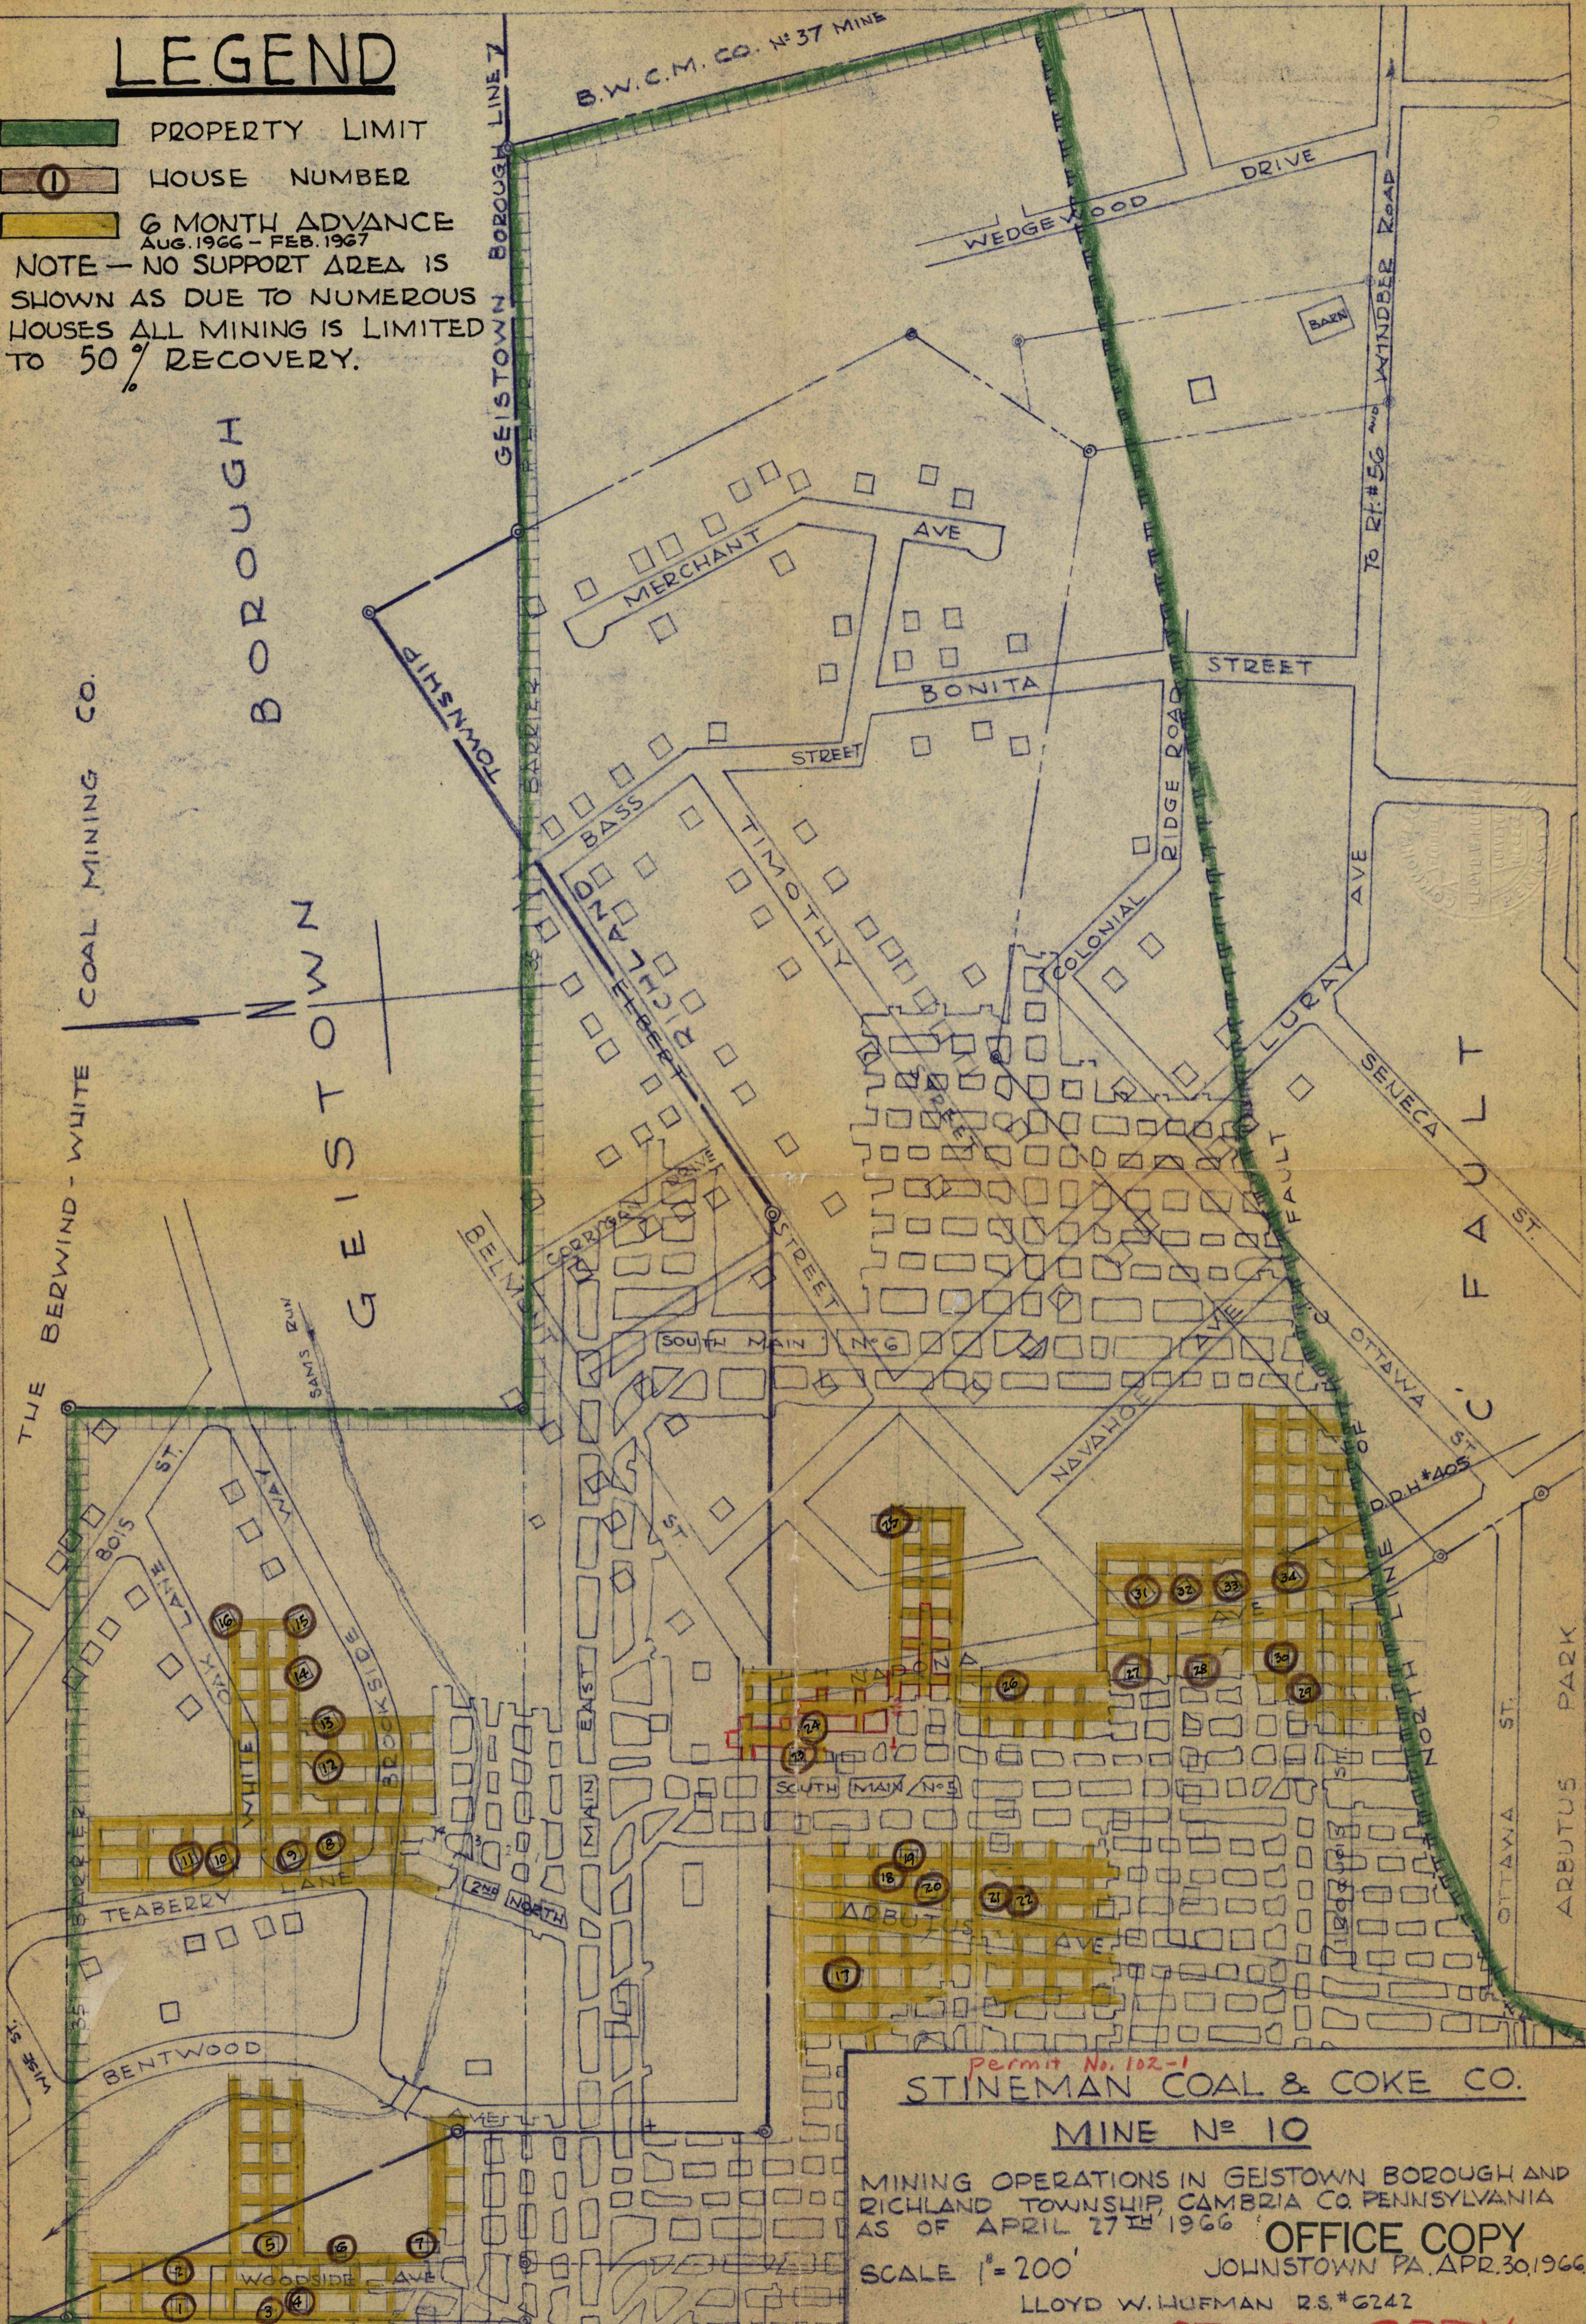

Permit No. 102-1
STINEMAN COAL & COKE CO.
MINE NO. 10

MINING OPERATIONS IN GEISTOWN BOROUGH AND RICHLAND TOWNSHIP, CAMBRIA CO. PENNSYLVANIA AS OF APRIL 27TH 1966
OFFICE COPY
 SCALE 1" = 200'
 JOHNSTOWN PA. APR. 30, 1966
 LLOYD W. HUFMAN R.S. #6242

OFFICE COPY