

**Stanford**  
PORTER TWP., JEFFERSON CO.  
**Doverspike Bros. Coal Co.**  
R.D. 4, Box 571, Punxsutawney, Pa. 15787  
**SUGARCAMP NO. 2**  
SHEET No. 2 of 16 SCALE 1"=200'  
**EXHIBIT "B"**


**LEGEND**

|                           |                            |
|---------------------------|----------------------------|
| PERMIT AREA               | POST 1966 DWELLINGS 10     |
| UNDERGROUND WORKINGS      | CEMETERIES 7               |
| TOWNSHIP BOUNDARY         | STRUCTURES □ or ■          |
| COUNTY BOUNDARY           | MAJOR ELECTRIC LINES — E — |
| TEST BOREHOLE ⊙           | PIPELINES — G —            |
| LOWER KITTINGING          | GAS WELLS ⊛                |
| COAL CONTOURS 1200        | WATER WELLS ⊙              |
| SURFACE WORKINGS          | STREAMS ———                |
| MINE OPENINGS, Not Sealed | LAKES or PONDS             |
| MINE OPENINGS, Sealed     | SPRING                     |
| PROPERTY LINES            | WATER TREATMENT FACILITIES |
| PRE 1966 DWELLINGS        | CONTIGUOUS PROPERTY        |

**LEGEND cont.**

|   |  |
|---|--|
| WATER   | 6 MONTH PROJECTIONS                      |
| SUPPORT AREA  | CONTEMPLATED MINING □ 1 No. 2            |
| COMPLETED MINING □  | CONTEMPLATED MINING □ 2/15/93 TO 2/15/94 |
| SURVEY STATION △  | COMPLETED MINING □                       |
| GAS WELL BARRIER ⊗ (No Mining Within Barrier Unless Approved) |  |

**COMMONWEALTH OF PENNSYLVANIA**  
REGISTERED PROFESSIONAL ENGINEER  
**JOSEPH P. KALYNCHUK**  
No. 042231  
5-4-93

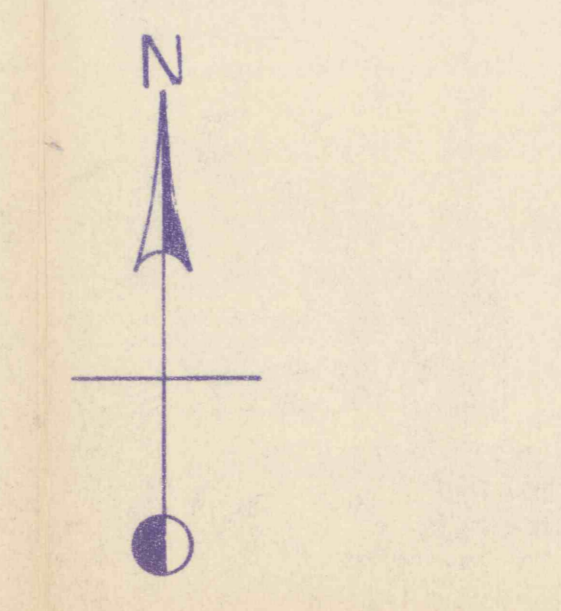

**DOVERSPIKE BROS. COAL CO.**  
**SUGARCAMP No. 2 MINE** SCALE: 1"=200'

DATE: \_\_\_\_\_

|                         |                             |
|-------------------------|-----------------------------|
| INTAKE AIR              | STOPPING W/ DOOR            |
| RETURN AIR              | CHECK CURTAIN               |
| PRIMARY ESCAPEWAY       | REGULATOR                   |
| SECONDARY ESCAPEWAY     | DOUBLE DOORS (Equip. doors) |
| BELT LINE               | OVERCAST                    |
| △ B-E POINTS (Approved) |                             |
| △ B-E POINTS (Proposed) |                             |
| — STOPPING              |                             |

Survey is closed loop. Accuracy is 1:10000  
Individuals responsible for information:  
Mark Pennsy, Engineer & Larry Smith, Superintendent