

Stanford
 PORTER TWP., JEFFERSON CO.
Doverspike Bros. Coal Co.
 R.D. 6 Box 271 Punxsutawney, Pa. 15787

SUGARCAMP NO. 2
 SHEET No. 3 of 16 SCALE 1"=200'

EXHIBIT "B"

LEGEND


PERMIT AREA	POST 1966 DWELLINGS
UNDERGROUND WORKINGS	CEMETERIES
TOWNSHIP BOUNDARY	STRUCTURES
COUNTY BOUNDARY	MAJOR ELECTRIC LINES
TEST BOREHOLE	PIPELINES
CROP LINES	GAS WELLS
COAL CONTOURS	WATER WELLS
SURFACE WORKINGS	STREAMS
MINE OPENINGS, Not Sealed	LAKES or PONDS
MINE OPENINGS, Sealed	SPRING
PROPERTY LINES	WATER TREATMENT FACILITIES
PRE 1966 DWELLINGS	CONTIGUOUS PROPERTY

LEGEND cont.

WATER	6 MONTH PROJECTIONS
SUPPORT AREA	CONTEMPLATED MINING
COMPLETED MINING	COMPLETED MINING
SURVEY STATION	SURVEY STATION
GAS WELL BARRIER	GAS WELL BARRIER

(No Mining Within Barrier Unless Approved)

Professional Engineer Seal
 JOSEPH P. KALYNSKIUK
 5-4-93
 SIGNATURE

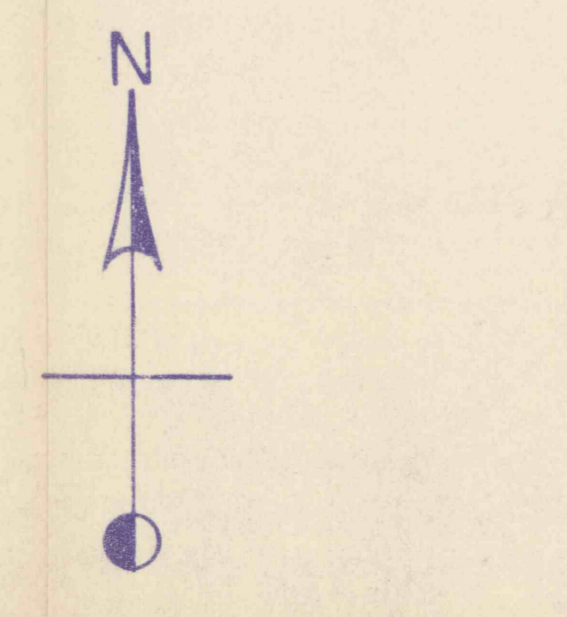

DOVERSPIKE BROS. COAL CO.
 SUGARCAMP No. 2 MINE SCALE: 1"=200'

DATE: _____	INTAKE AIR	STOPPING W/ DOOR
	RETURN AIR	CHECK CURTAIN
	PRIMARY ESCAPEWAY	REGULATOR
	SECONDARY ESCAPEWAY	DOUBLE DOORS (Equip. doors)
	BELT LINE	OVERCAST
	B-E POINTS (Approved)	
	B-E POINTS (Proposed)	
	STOPPING	

Survey is closed loop. Accuracy is 1:10000
 Individuals responsible for information:
 Mark Pennys, Engineer & Larry Smith, Superintendent