

JAMES THOMPSON

JAMES

MARTIN

# MINED OUT No 9 MINE

WILLIAM BARTON NOW  
PA. GAME COMMISSION

SURFACE-STATE GAME COMMISSION  
CIDALF HIRAM SWANK'S SONS

H. KEPPLER NOW PA. GAME COMMISSION

HY. RTE 53 3/4 MILE  
HEN RUN

LEWIS WOLF  
SWANK No 10 MINE

MINING AREA  
MAY 30 TO DEC. 1, 1968

Mining Area  
May 30, 1968 to  
Nov. 30, 1968

Mined Out to  
May 30, 1968

AMENDED  
40 ACRES  
MAY 1968


WILLIAM TILTON

MINED OUT PREVIOUSLY  
FIRST MINING  
NO AVAILABLE MAP  
CHAIN PILLARS & HEADING STUMPS RECOVERABLE

SURFACE-STATE GAME  
COAL - DON BENNIE

EZRA KIEL FARMER

1"=400'

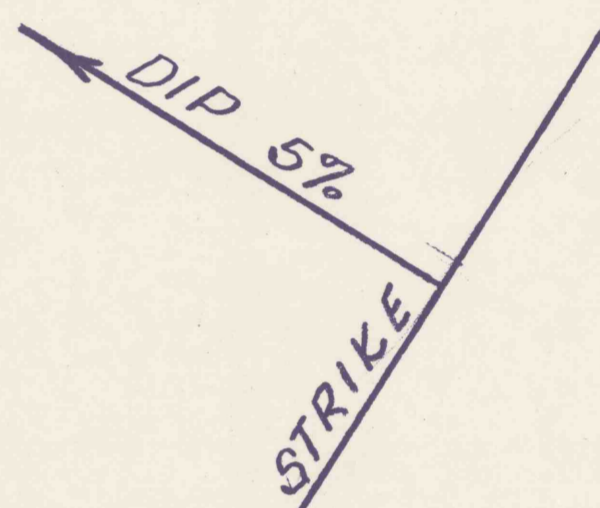


FAULTED AREA

MINED OUT


M. KEPPLER NOW PA. GAME COMMISSION

MAIN HEADING OLD DOUGHERTY MINE

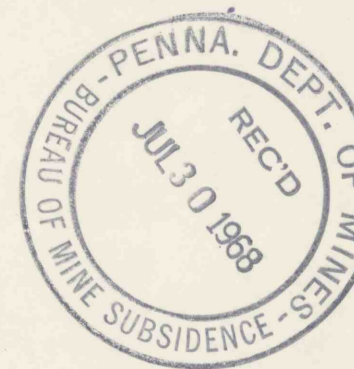

SWANK No 13 MINE  
PERMIT No 158-1  
DAVIS COAL CO.  
C-PRIME  
DEAN TWP, CAMBRIA Co., PA.

SCALE: 1"=200'  
8-20-1966 66-11-109

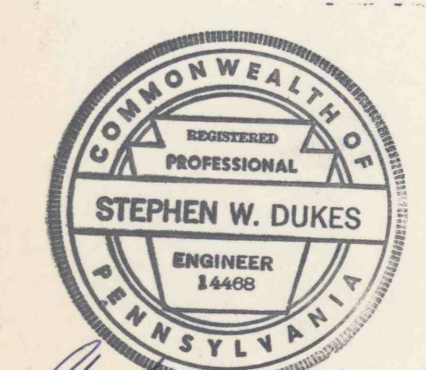

Stephen W. Dukes  
7-29-68