


**O'DONNELL No. 4 MINE**



**PLUMCREEK MINE**  
FINAL MINE MAP  
POSTING DATE - 12/1/99  
SCALE 1" = 200'

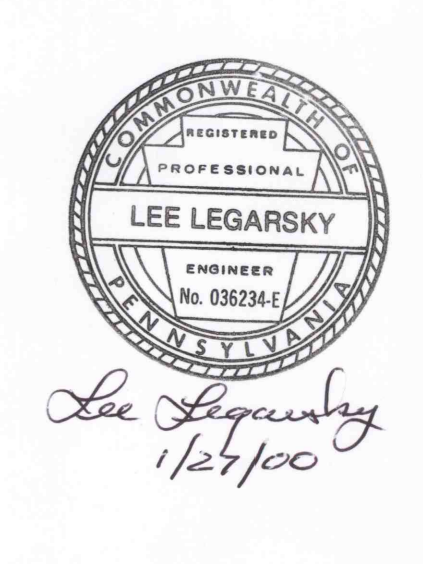