



SHEET NO. 1

FIT TO SHEET NO. 2


SURFACE OWNERSHIP


NOTE: A 3" water line exists along T-630 and T-342 as per the Lewis of the East Dunkard Water Association.

- LEGEND**
- UNDERGROUND PERMIT BOUNDARY
 - AMENDMENT AREA II
 - SUBSIDENCE CONTROL PLAN BOUNDARY
 - ADDITIONAL CONTROL PLAN BOUNDARY (APPROVED 4-6-2000)
 - FIRST MINING ONLY AREA
 - COAL CONTOUR
 - SURVEY STATION - UNDERGROUND
 - SURVEY STATION - SURFACE
 - PERMANENT MONUMENT - SURFACE
 - DRILLING STRUCTURE
 - INVENTORIED BUILDING (See Module 18.1 of structure inventory list)
 - STREAM
 - 100' COVER LINE
 - PUBLIC ROAD (STATE OR TWP)
 - GAS LINE
 - GAS WELL
 - PROPERTY LINE
 - (S-22) PROPERTY ID NUMBERS
 - SURFACE OWNERSHIP (KEYED TO MODULE 5)
 - COAL OWNERSHIP (KEYED TO MODULE 5)
 - ZONES OF POTENTIAL INFLUENCE (O/A - INTERMITTENT STREAM)
 - PILLARED AREA
 - PILLARED AREA


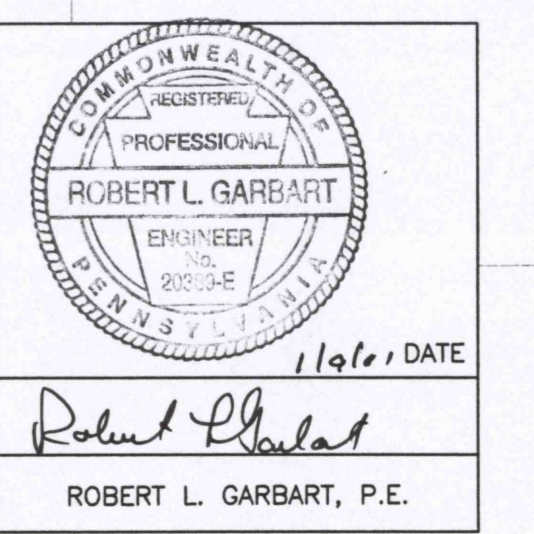

GENESIS, INC. dba MEADOW RUN GENESIS, INC.
 P.O. BOX 552
 SOMERSET, PA 15563
FINAL MAP
MINING COMPLETED ON 12-1-2000
MEADOW RUN MINE
 SEWICKLEY COAL SEAM
 DUNKARD TWP., GREENE CO, PA
 MSHA ID # 36-07987
 CMAP #30871301
 SCALE 1"=200' JANUARY 9, 2001
 SURVEY UPDATED JUNE 13, 2000
 Prepared by: **Garbart Consulting Services, Inc.** JAN 16 2001
 PO Box 44, Lemont Furness, PA 15468 Dept. of Environmental Protection
 (724) 438 - 1313

SHEET NO. 1

MEADOW RUN - FIN

DATE: 03/12/01 11:20:01