



28C

28C

MATCH SHEET 11C S 15,000

A. T. & T. Cable

T-363 WILLIAM HOWELL 73.55AC.

T-366 ROBERT S. ROBERTS 122.81AC.

T-364 ABRAHAM REESE 76.09AC.

33-52 VENT HOLE SUR 204661

33-53 VENT HOLE SUR 198261

T-366 ROBERT S. ROBERTS 122.81AC.

DRY GAS WELL No. 124

A-SOUTH MAIN

T-377 W.R. JONES 108.11AC.

T-376 WINFIELD ROBERTS 87.31AC.


T-375 LEMUEL HUGHES 223.34AC.

T-378 WM. ROBERTS 98.94AC.

CAMBRIA SUMMERHILL

TOWNSHIP TOWNSHIP

T-379 LINCOLN ROBERTS 155.97AC.

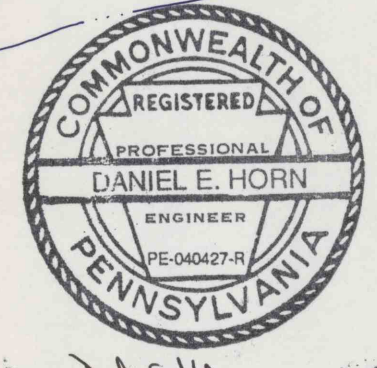

MANOR REALEST. 9.4 AC

28C

MATCH SHEET 32C S 15,000

MINE - 33

28C

REVISED 1-86 FINAL