MATCH SHEET 9 N1,000

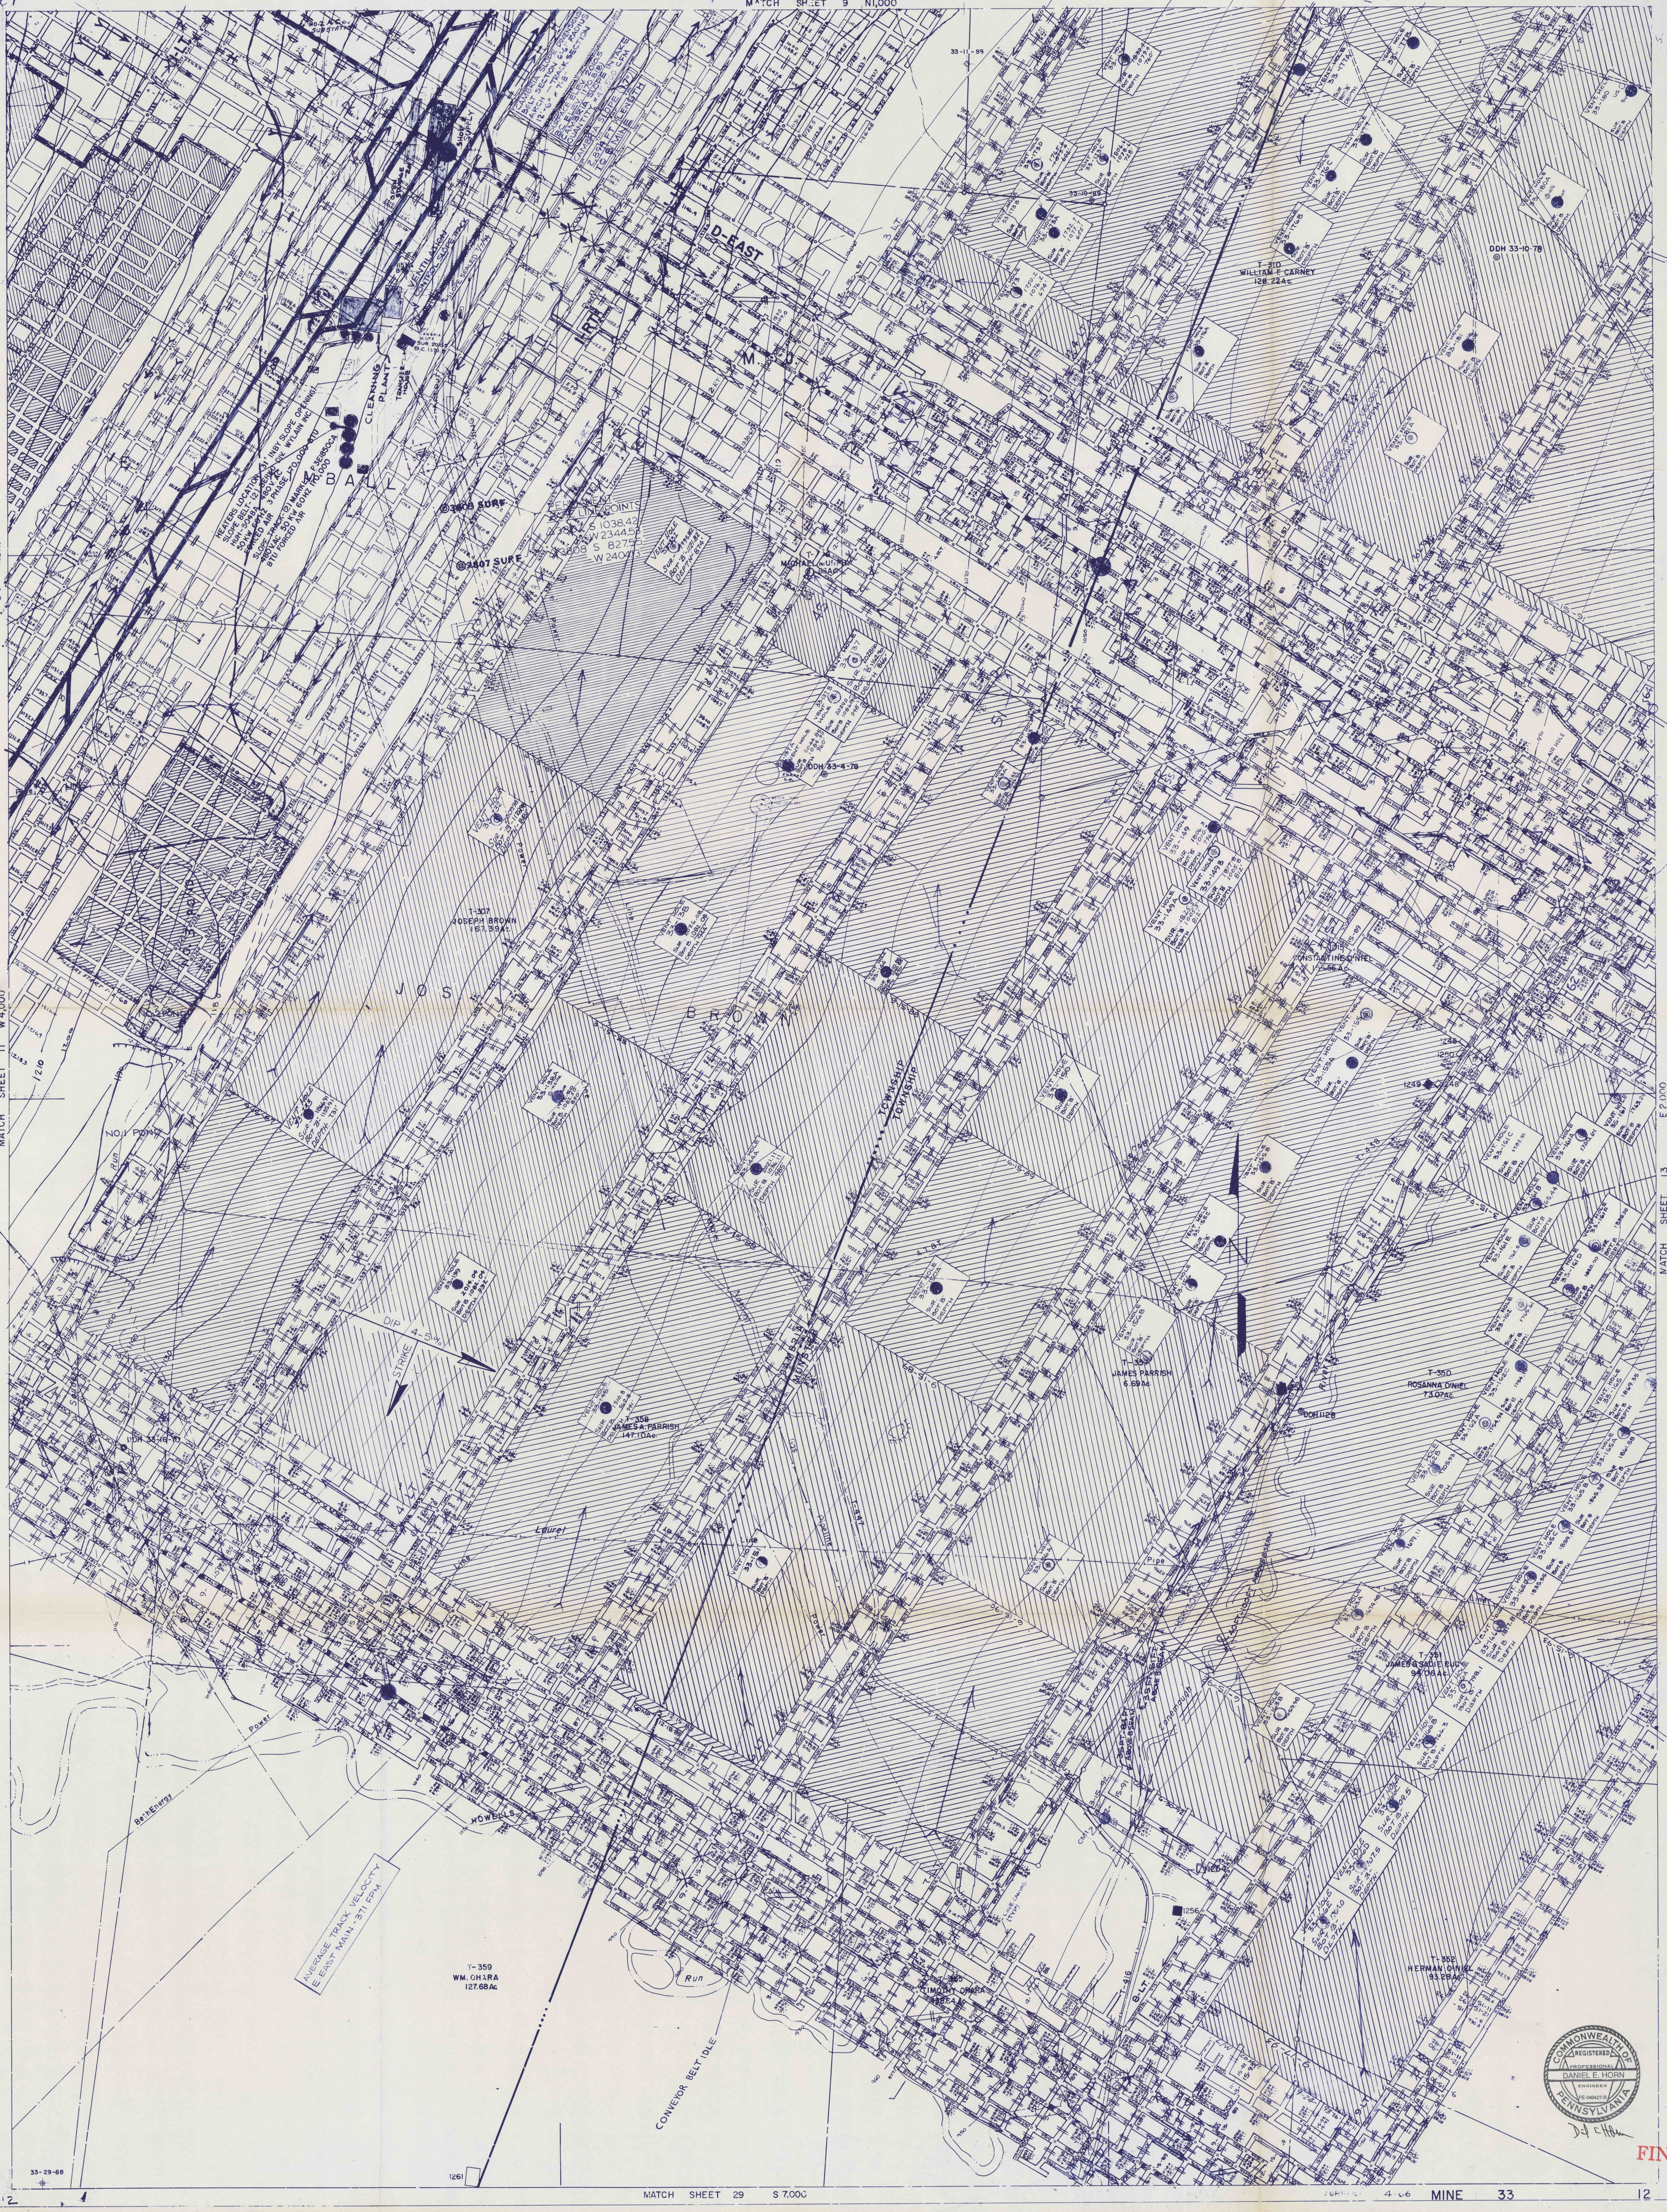

MATCH SHEET 11 W 4,000

MATCH SHEET 13 E 2,000

MATCH SHEET 29 S 7,000

SURVEYED 4-66 MINE 33 12

COMMONWEALTH OF PENNSYLVANIA
REGISTERED PROFESSIONAL
DANIEL E. HORN
ENGINEER
PE-040427-R

D E Horn

FINAL