

YELLOW
BROWN.

20 ACRES SURFACE

MINED OUT.

MINED OUT.

MINED OUT.

WILLIAM KINNEAR.

102.17 ACRES.

E SEAM LEASED FROM DENNISTON HEIRS.
"B" SEAM OWNED IN FEE BY
TAYLOR & MCGOY COAL & COKE CO.

BINGHAM

254.13 AS.

E SEAM LEASED FROM DENNISTON HEIRS.
"B" SEAM OWNED IN FEE BY
TAYLOR & MCGOY C. & C. CO.

MINED OUT.

SCOPE
PORTAL

SHALLOW
COVER

ALL MIN

MINED OUT.



MINING AREA
MAY 1, 1969 - OCT 1, 1969

NOTE - NO REVISIONS, MINE TEMPORARILY IDLE.

MINED OUT.

VINGLAS COAL CO.
CRESSON TWP. CAMBRIA CO.
SCALE 1" = 200'
E SEAM

TAYLOR & MCGOY MINE

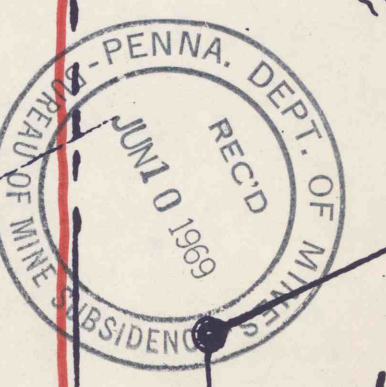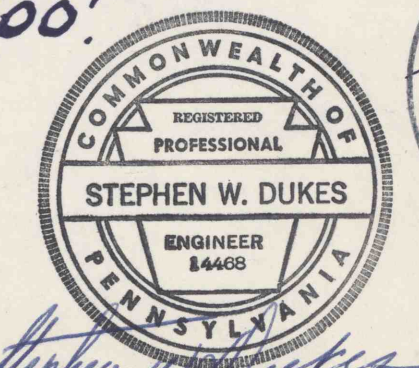

ALL MIN

FIELD COPY

AM
HEIR