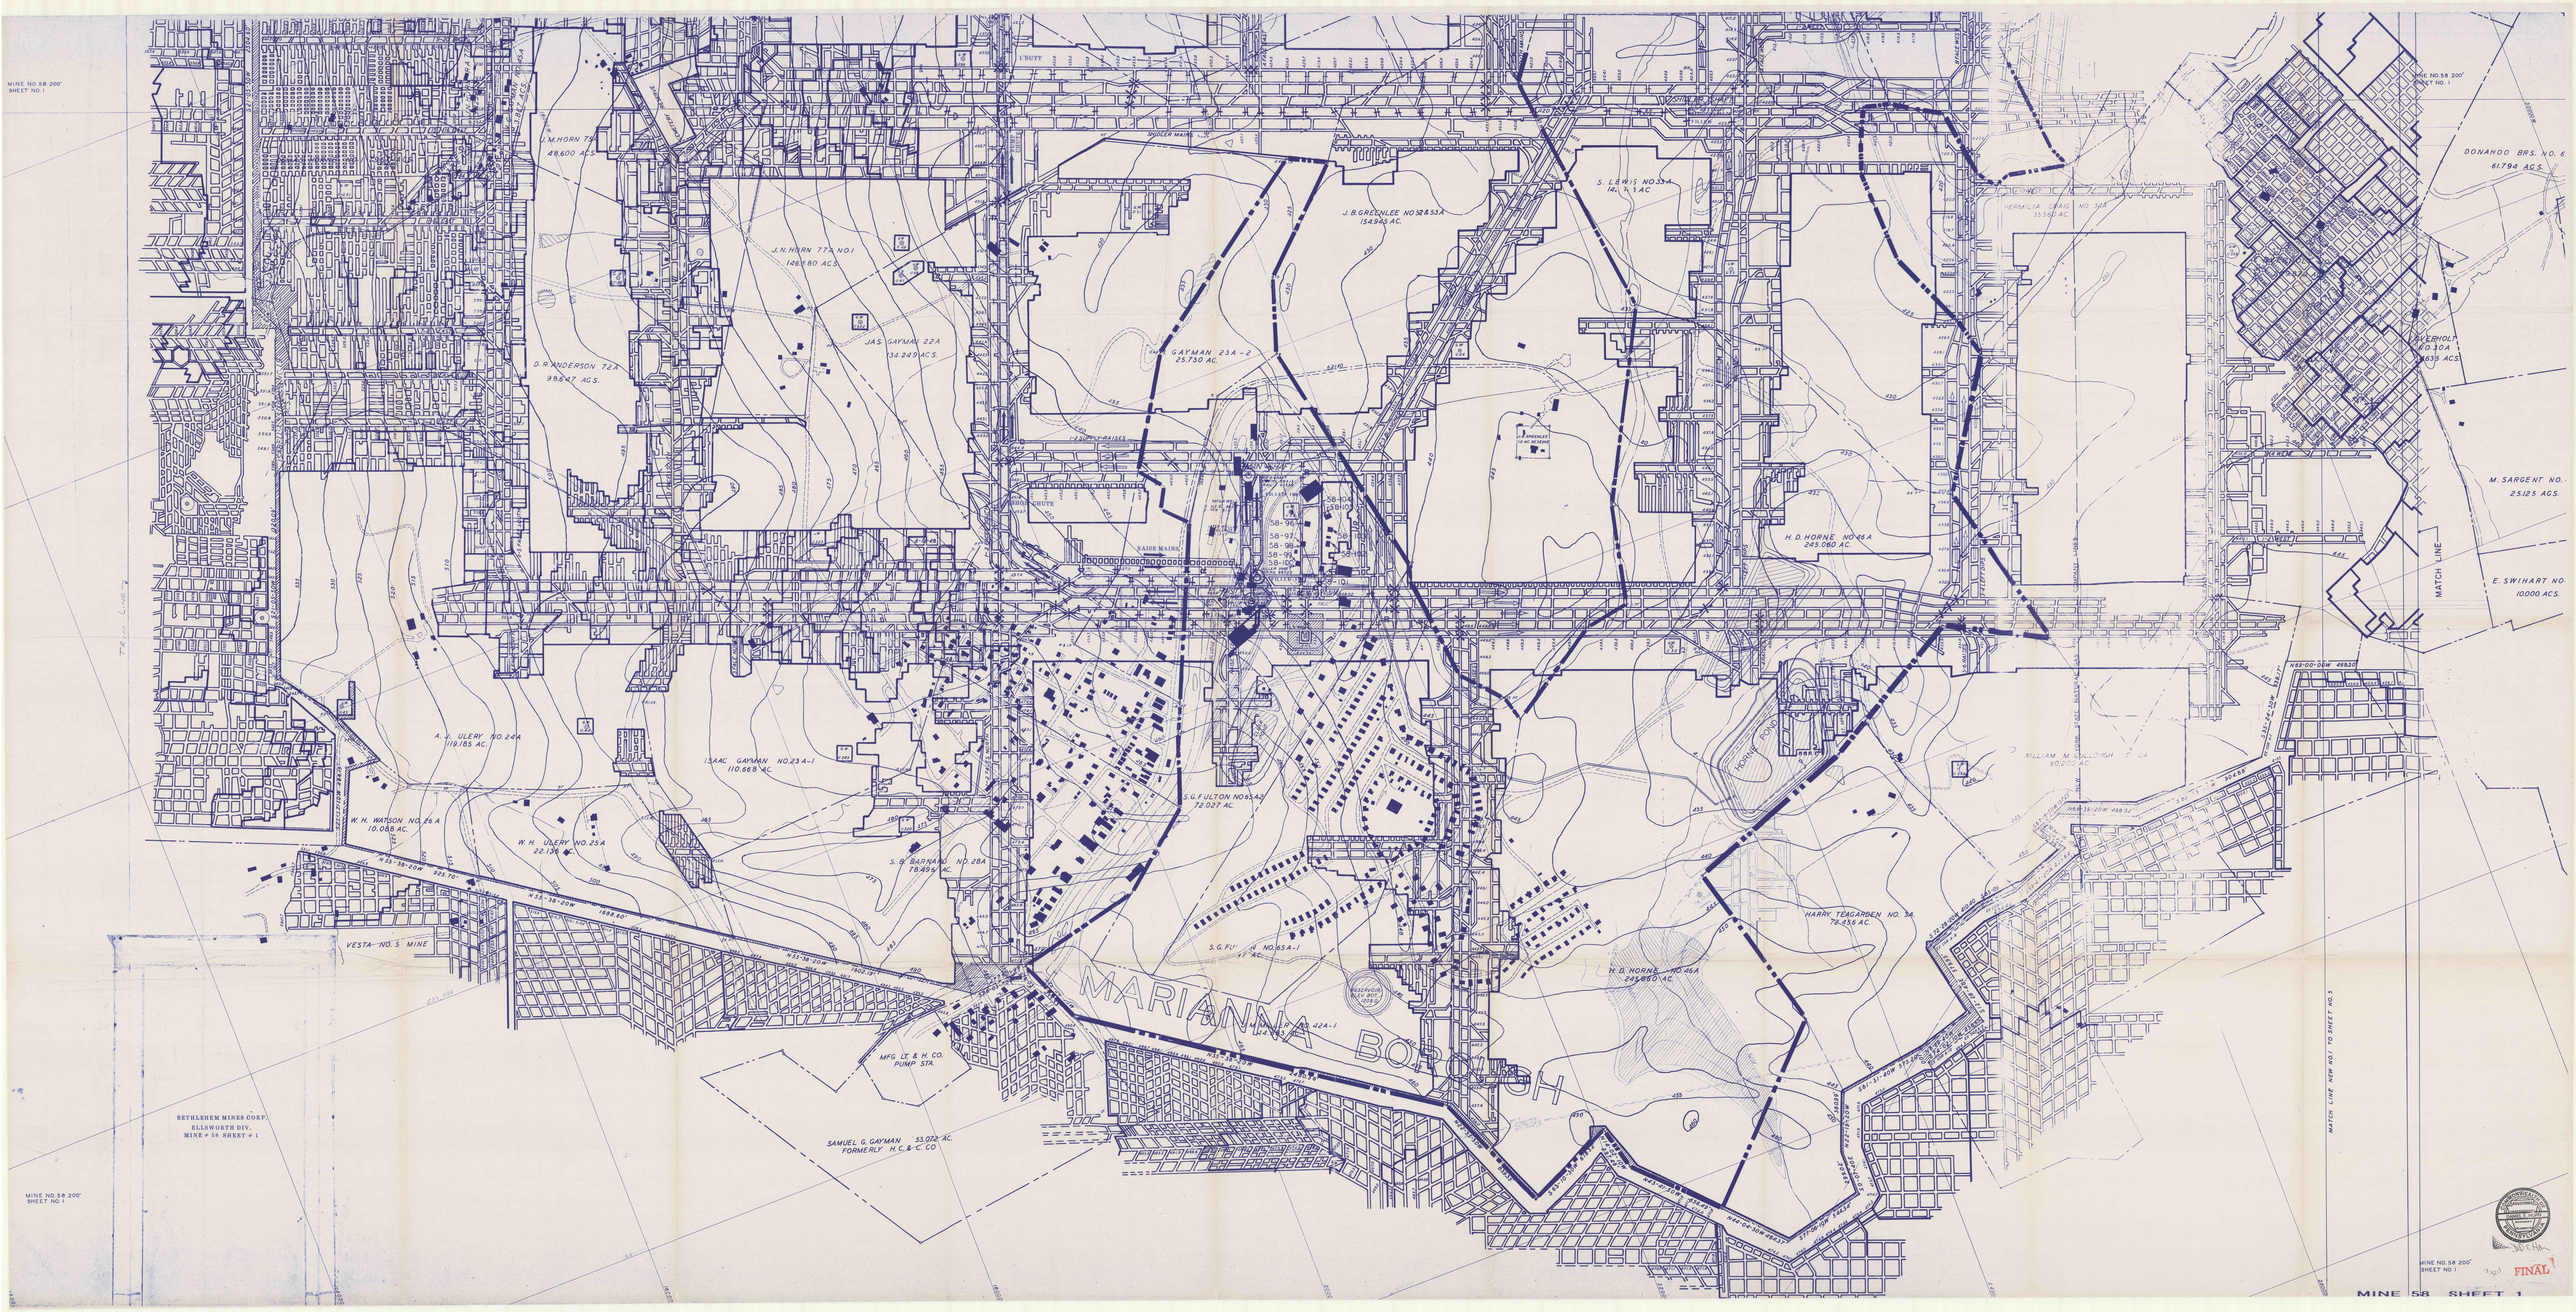
MINE NO. 58 200'
SHEET NO. 1
J.M. HORN 75
48,600 ACS.
J.N. HORN 77A NO. 1
146,680 ACS.
JAS. GAYMAN 22A
134,249 ACS.
D.R. ANDERSON 72A
98,647 ACS.
J.B. GREENLEE NO. 52 & 53A
154,945 AC.
S. LEWIS NO. 33A
GAYMAN 23A-2
25,730 AC.
H. D. HORNE NO. 46A
245,060 AC.
DONAHOO BRS. NO. 6
61,794 ACS.
M. SARGENT NO.
25,125 ACS.
E. SWIHART NO.
10,000 ACS.
MATCH LINE
A. J. ULERY NO. 24A
119,185 AC.
ISAAC GAYMAN NO. 23A-1
110,668 AC.
W. H. WATSON NO. 26A
10,088 AC.
W. H. ULERY NO. 25A
22,136 AC.
S. B. BARNARD NO. 28A
78,496 AC.
S. G. FULTON NO. 65A-2
72,027 AC.
HARRY TEAGARDEN NO. 3A
72,456 AC.
VESTA NO. 5 MINE
MARIANNA BOROUGH
MFG. LT. & H. CO.
PUMP STA.
SAMUEL G. GAYMAN 53,072 AC.
FORMERLY H.C. & C. CO.
BETHLEHEM MINES CORP.
ELLSWORTH DIV.
MINE # 58 SHEET # 1
MATCH LINE NEW NO. 1 TO SHEET NO. 5
FINAL
MINE 58 SHEET 1