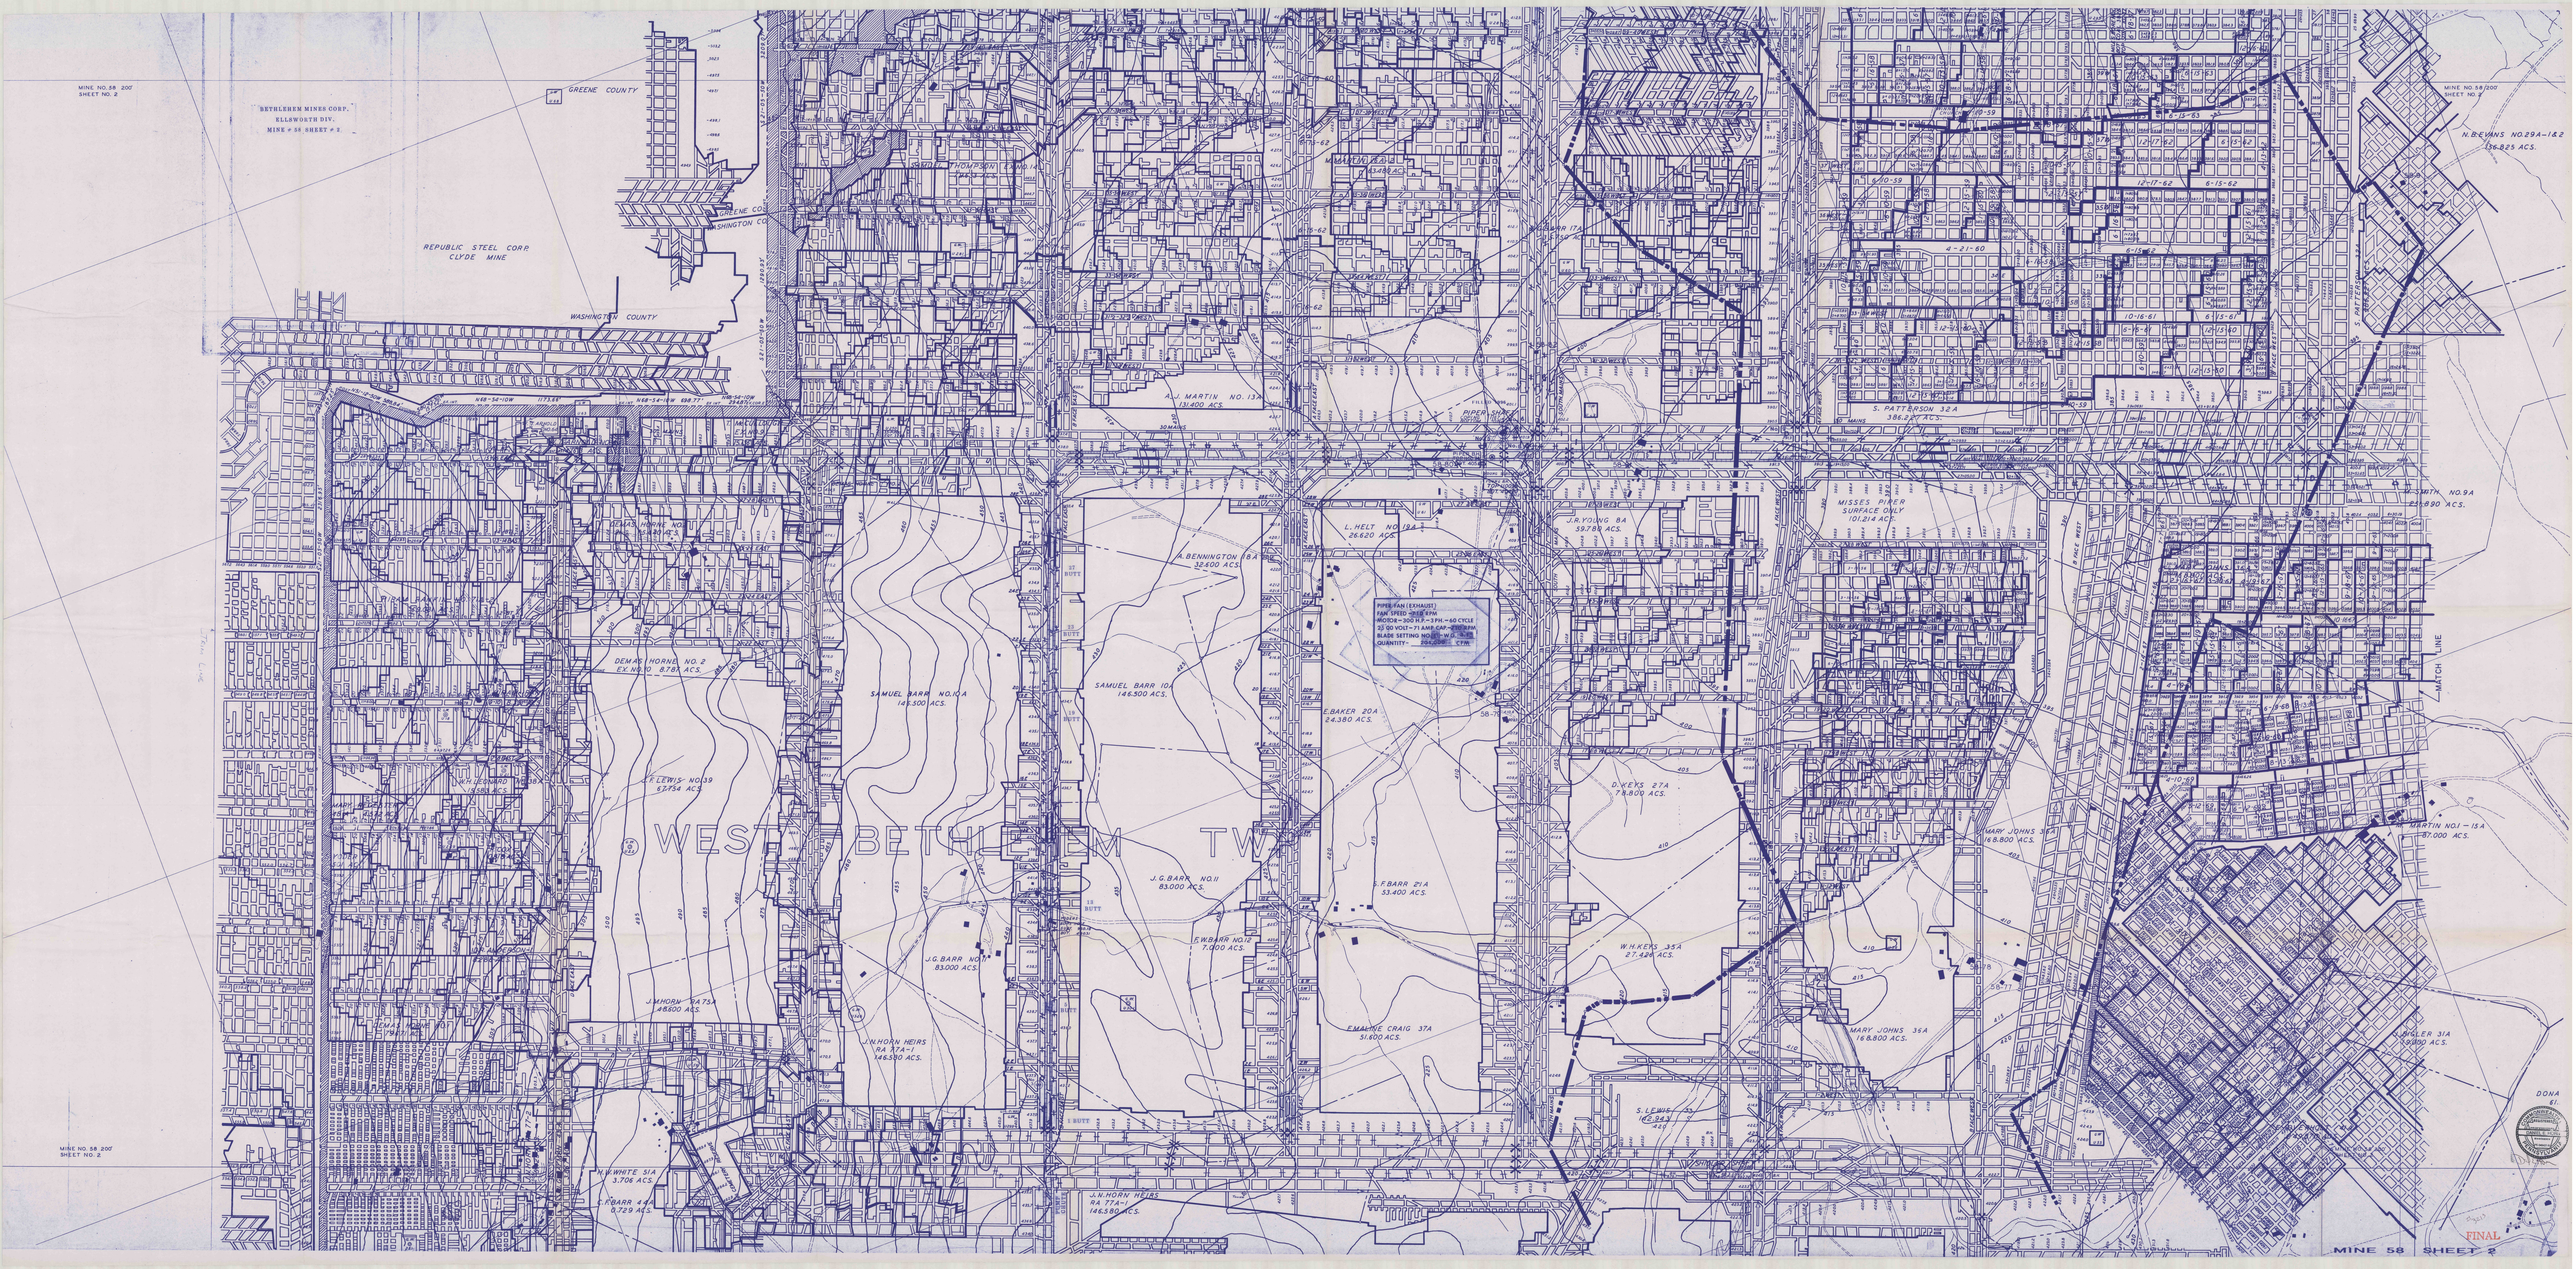

BETHLEHEM MINES CORP.
ELLSWORTH DIV.
MINE # 58 SHEET # 2
GREENE COUNTY
WASHINGTON COUNTY
REPUBLIC STEEL CORP
CLYDE MINE
MINE NO. 58 207
SHEET NO. 2
MINE NO. 58/200
SHEET NO. 7
WEST BETHLEHEM TWP
MATCH LINE
A.J. MARTIN NO. 13A
13.400 ACS.
L. HELT NO. 19A
26.620 ACS.
A. BENNINGTON 8A
32.600 ACS.
J.R. YOUNG 8A
39.780 ACS.
MISSES PIPER
SURFACE ONLY
101.214 ACS.
S. PATTERSON 32A
386.2 ACS.
N. EVANS NO. 29A-1&2
136.825 ACS.
DEMAREST HORNE NO. 2
EX NO. 10 87.8A ACS.
SAMUEL BARR NO. 10A
146.500 ACS.
SAMUEL BARR 10A
146.500 ACS.
E. BAKER 20A
24.380 ACS.
D. KEYS 27A
78.800 ACS.
MARY JOHNS 35A
168.800 ACS.
F. LEWIS NO. 39
57.754 ACS.
J.G. BARR NO. 11
83.000 ACS.
F. BARR 21A
53.400 ACS.
E.W. BARR NO. 12
71.000 ACS.
J.G. BARR NO. 9
83.000 ACS.
J.W. HORN 19A 75A
146.600 ACS.
J.N. HORN HEIRS
RA 174-1
146.590 ACS.
W.H. KEYS 35A
27.426 ACS.
E. MAXINE CRAIG 37A
51.600 ACS.
S. LEWIS
42.843 ACS.
K.W. WHITE 51A
3.706 ACS.
F. BARR 44A
0.729 ACS.
J.N. HORN HEIRS
146.580 ACS.
ANGLER 31A
49.900 ACS.
MARTIN NO. 9A
24.890 ACS.
MARTIN NO. 1-15A
87.000 ACS.
PIPER FAN (EXHAUST)
FAN SPEED-3558 R.P.M.
MOTOR-200 H.P.-3 PH.-60 CYCLE
33 00 VOLT-71 AMP.-OPERATING
BLADE SETTING NO. 11-W.G. 4.75
QUANTITY- 290,000 C.F.M.
FINAL
MINE 58 SHEET 2