

CONNERS B.H. #4
SURF. EL. 1129.84
BOT. EL. 395.8


REPUBLIC STEEL CORP.
CLYDE MINE

MATCH OLD SH. 5

MATCH SH. 12

MATCH SH. 6

SCALE: 1" = 200' MINE 58 SHEET 7

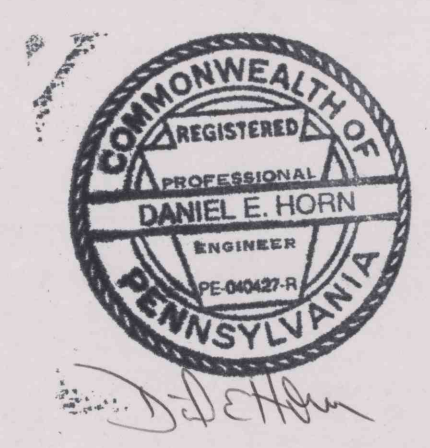

43213

FINAL