


MATCH TO SHEET 21

MATCH TO SHEET 20

MATCH TO SHEET 23 MATCH TO SHEET 25

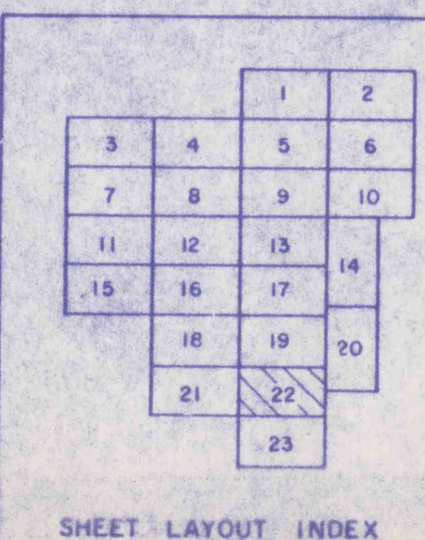

**LEGEND FOR MINERAL OWNERSHIP**

(1)	WOOD COAL - LEASE
(2)	PILGRIM COAL - LEASE
(3)	MUSE COAL - LEASE
(4)	PENN ALLEGH COAL PROPERTY
(A)	FAWN DEVELOPMENT CORP.
(B)	DO NOT OWN

**LEGEND FOR THE 6 MONTH SURFACE SUPPORT PROJECTIONS**

AREA OF PROJECTED MINING FROM: TO:	SURVEY STATION	6509+
AREA OF 50% MINING	ELEVATION	820.1-
PROTECTED STRUCTURE	SINGLE LINE PROJECTION OF ENTRIES & CROSSCUTS HAVING A MAXIMUM WIDTH OF 20 FEET	
STRUCTURE		

NOTE: ANY PROJECTED COAL PILLAR FULLY OR PARTIALLY WITHIN AN AREA DESIGNATED FOR 50% MINING SHALL BE LEFT IN PLACE INTACT



*Alfred Reisz*

**ALLEGHENY No. 2 & PORTAL No. 3 MINE**  
**UPPER FREEPORT COAL SEAM**  
**ALLEGHENY COUNTY: FAWN, FRAZER & HARRISON TOWNSHIPS**  
**BUTLER COUNTY: BUFFALO & CLINTON TOWNSHIPS**  
**PENN ALLEGH COAL CO., INC.**  
**ADDRESS: BOX 238 A, RD 2, TARENTUM, PA. 15084**  
**SCALE 1" = 200'**    **SURVEY DATE: 7/31/92**    **SHEET No. 22**