


MATCH TO SHEET 17 MATCH TO SHEET 17

MATCH TO SHEET 22 MATCH TO SHEET 22

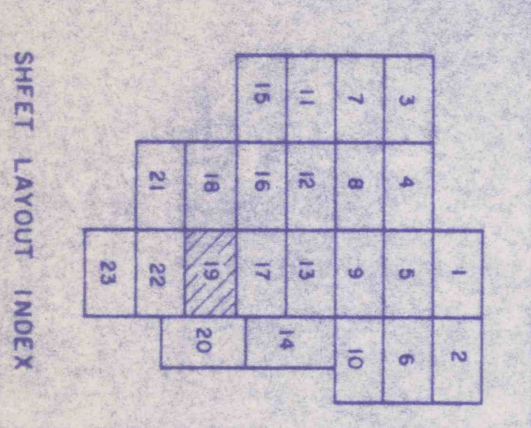

- LEGEND FOR MINERAL OWNERSHIP**
- (1) WOOD COAL - LEASE
 - (2) PUGHRIN COAL - LEASE
 - (3) MUSE COAL - LEASE
 - (4) PENN ALLEGH COAL PROPERTY
 - (5) FAWN DEVELOPMENT CORP
 - (a) DO NOT OWN

- LEGEND FOR THE 6 MONTH SURFACE SUPPORT PROJECTIONS**
- AREA OF PROJECTED MINING FROM _____ TO _____
 - AREA OF 50% MINING PROTECTED STRUCTURE
 - STRUCTURE
 - SURVEY STATION
 - ELEVATION
 - SINGLE LINE PROTECTION OF ENTRIES & CROSSCUTS HAVING A MAXIMUM WIDTH OF 20 FEET
- NOTE: ANY PROJECTED COAL PILLAR FILLS OR PARTIALLY WITHIN AN AREA DESIGNATED FOR 50% MINING SHALL BE LEFT IN PLACE. INSET



Alfred Reiz

ALLEGHENY No. 2 & PORTAL No. 3 MINE
 UPPER FREEPORT COAL SEAM
 ALLEGHENY COUNTY: FAWN, FRAZER & HARRISON TOWNSHIPS
 BUTLER COUNTY: BUFFALO & CLINTON TOWNSHIPS
PENN ALLEGH COAL CO., INC.
 ADDRESS: BOX 238 A, RD 2, TARENTUM, PA. 15084
 SCALE 1" = 200'
 SURVEY DATE: 7/25/72
 SHEET No. 19