

MATCH TO SHEET 18


MATCH TO SHEET 19

MATCH TO SHEET 20

MATCH TO SHEET 21

MATCH TO SHEET 17

MATCH TO SHEET 22

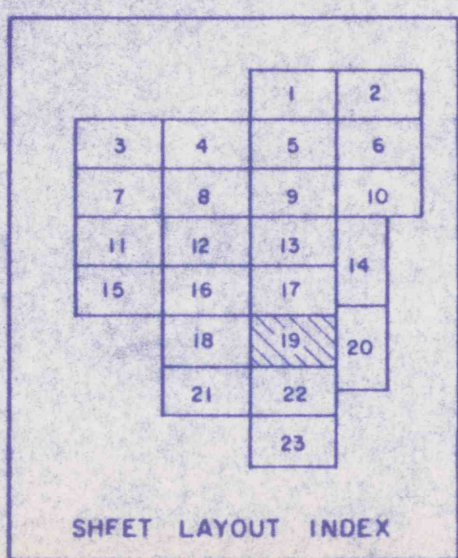


**LEGEND FOR MINERAL OWNERSHIP**

(1)	WOOD COAL - LEASE
(2)	PILGRIM COAL - LEASE
(3)	MUSE COAL - LEASE
(4)	PENN ALLEGH COAL PROPERTY
(5)	FAWN DEVELOPMENT CORP
(6)	DO NOT OWN

**LEGEND FOR THE 6 MONTH SURFACE SUPPORT PROJECTIONS**

AREA OF PROJECTED MINING FROM: TO:	SURVEY STATION	6367+
AREA OF 50% MINING	ELEVATION	920.1-
PROTECTED STRUCTURE	SINGLE LINE PROJECTION OF ENTRIES & CROSSCUTS HAVING A MAXIMUM WIDTH OF 20 FEET	
STRUCTURE		

NOTE: ANY PROJECTED COAL PILLAR FULLY OR PARTIALLY WITHIN AN AREA DESIGNATED FOR 50% MINING SHALL BE LEFT IN PLACE INTACT

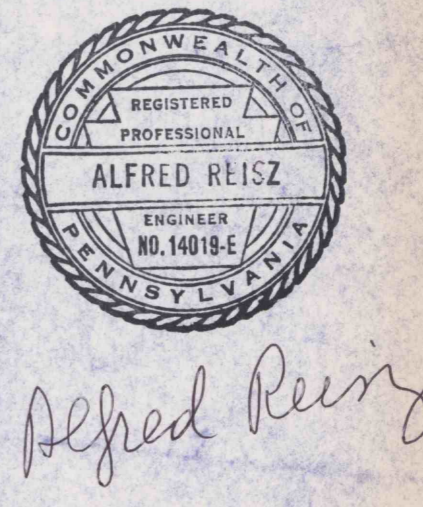

**ALLEGHENY No. 2 & PORTAL No. 3 MINE**  
**UPPER FREEPORT COAL SEAM**  
 ALLEGHENY COUNTY: FAWN, FRAZER & HARRISON TOWNSHIPS  
 BUTLER COUNTY: BUFFALO & CLINTON TOWNSHIPS  
**PENN ALLEGH COAL CO., INC.**  
 ADDRESS: BOX 238A, RD 2, TARENTUM, PA. 15084  
 SCALE 1" = 200' SURVEY DATE: 7/31/92 SHEET No. 19

