

**LEGEND**

INTAKE AIR	→
RETURN AIR	←
STOPPING WITH DOOR	
TEMPORARY STOPPING	
CHECK CURTAIN	—
LINE BRATTICE	—
OVERCAST	—
OVERCAST, PROJECTED	—
BELT LINE	—
BELT LOADING POINT	—
REGULATOR	—
PROPOSED SEALS	—
AREA PROJECTED TO BE MINED	—
OIL OR GAS WELL	—
EQUIPMENT DOOR	—
BLEEDER EVALUATION POINT	—
TEST HOLE	—
AREA SAMPLING POINT	—
INTAKE ESCAPEWAY	—
RETURN ESCAPEWAY	—

**FAN INFORMATION**

FAN	NAME AND TYPE	JEFFREY, DUNBAR
	AREA	1/84
	BLADE SETTING	25 - 25
	FAN MOTOR	LOUIS ALLEGH COAL CO. INC.
	TYPE	300 HP
	SIZE	30" DIA
	COMMENT	2500 VOLTS A.C.
	AIR QUANTITY	2500 CFM
	VENTILATING PRESSURE	WVG

**LEGEND FOR MINERAL OWNERSHIP**



(1)	WOOD COAL - LEASE
(2)	PILGRIM COAL - LEASE
(3)	MUSE COAL - LEASE
(4)	PENN ALLEGH COAL PROPERTY
(5)	FAWN DEVELOPMENT CORP.
(6)	DO NOT OWN

**LEGEND FOR THE 6 MONTH SURFACE SUPPORT PROJECTIONS**

AREA OF PROJECTED MINING	FROM: TO:	SURVEY STATION	38897*
AREA OF 50% MINING		ELEVATION	620' -
PROTECTED STRUCTURE		SINGLE LINE PROJECTION OF ENTRIES & CROSSCUTS HAVING A MAXIMUM WIDTH OF 20 FEET	

NOTE: ANY PROJECTED COAL PILLAR FULLY OR PARTIALLY WITHIN AN AREA DESIGNATED FOR 50% MINING SHALL BE LEFT IN PLACE INTACT

**ALLEGHENY No. 2 & PORTAL No. 3 MINE**  
 UPPER FREEPORT COAL SEAM  
 ALLEGHENY COUNTY: FAWN, FRAZER & HARRISON TOWNSHIPS  
 BUTLER COUNTY: BUFFALO & CLINTON TOWNSHIPS  
 PENN ALLEGH COAL CO., INC.  
 ADDRESS: BOX 238 A, RD 2, TARENTUM, PA. 15084  
 SCALE 1" = 200'  
 SURVEY DATE: 7/8/92  
 SHEET No. 18

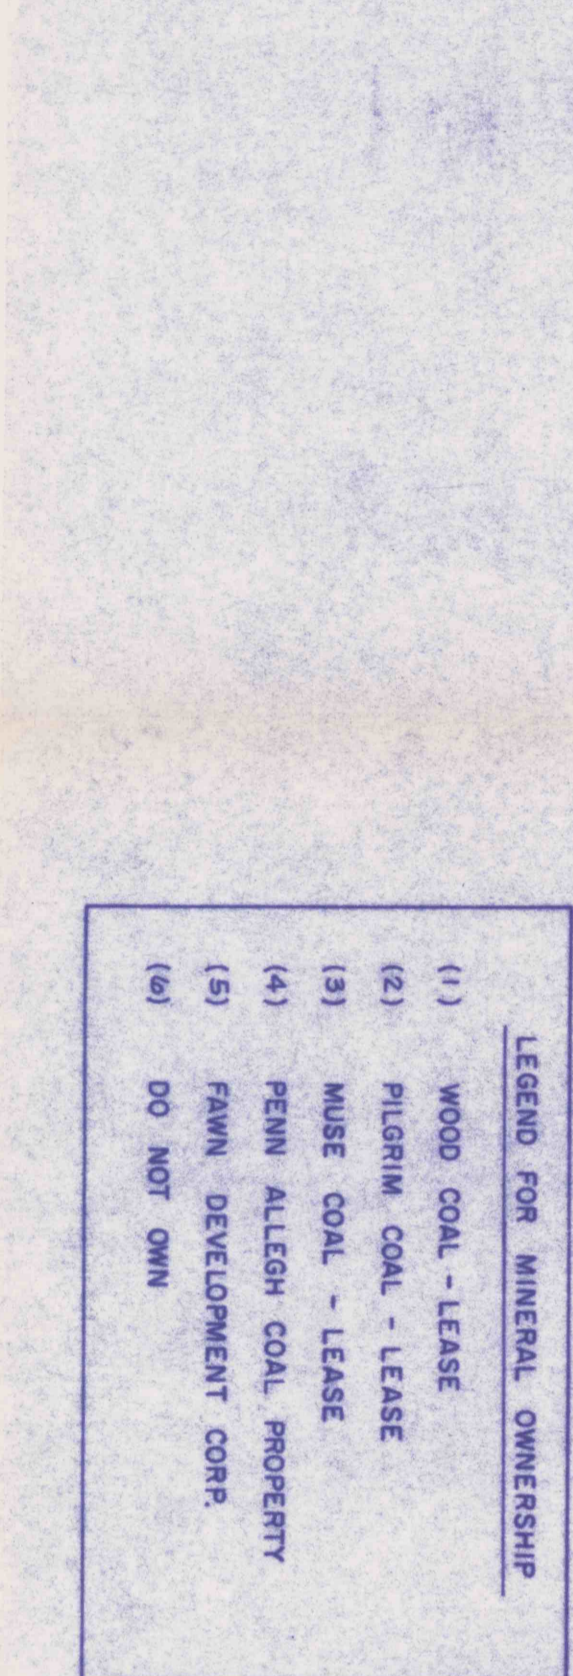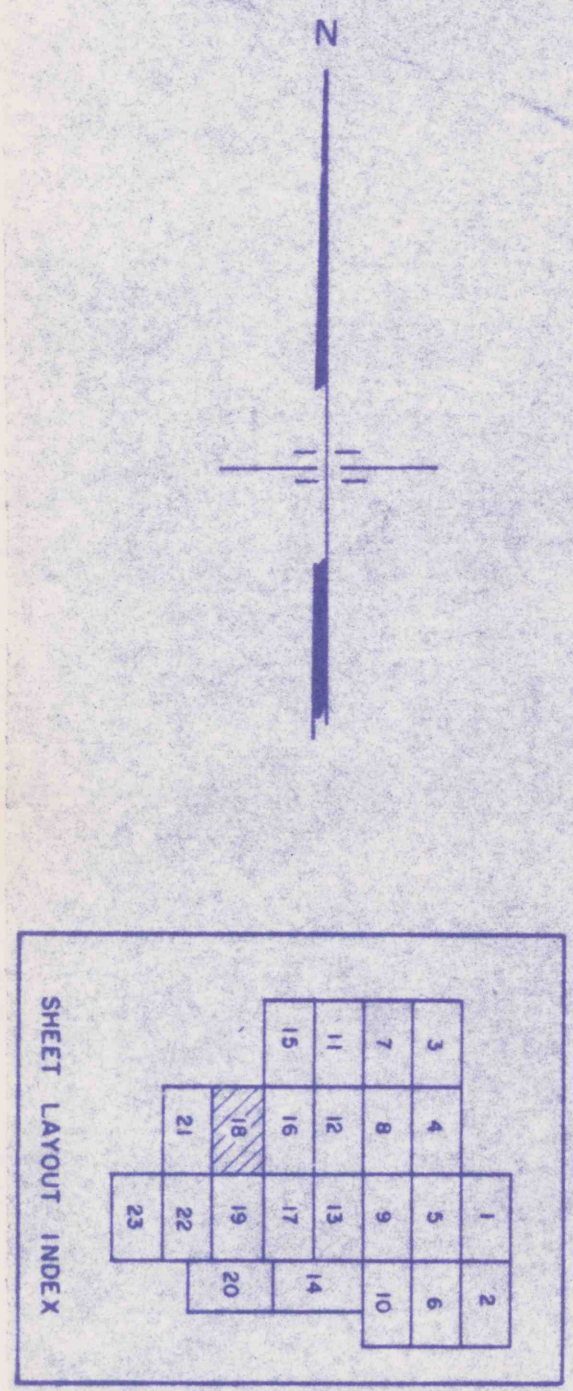





MATCH TO SHEET 19 MATCH TO SHEET 19