

MATCH TO SHEET 16

MATCH TO SHEET 16

MATCH TO SHEET 16

MATCH TO SHEET 13

MATCH TO SHEET 13


MATCH TO SHEET 19

MATCH TO SHEET 19

MATCH TO SHEET 20

MATCH TO SHEET 20

MATCH TO SHEET 20

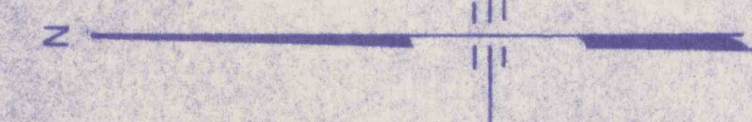

SHEET LAYOUT INDEX

	1	2
3	4	5
7	8	9
11	12	13
15	16	17
18	19	20
21	22	23

LEGEND FOR MINERAL OWNERSHIP

(1)	WOOD COAL - LEASE
(2)	PILGRIM COAL - LEASE
(3)	MUSE COAL - LEASE
(4)	PENN ALLEGH COAL PROPERTY
(5)	FAWN DEVELOPMENT CORP. - LEASE
(6)	DO NOT OWN

LEGEND FOR THE 6 MONTH SURFACE SUPPORT PROJECTIONS

AREA OF PROJECTED MINING FROM: TO:	SURVEY STATION
AREA OF 50% MINING	ELEVATION
PROTECTED STRUCTURE	SINGLE LINE PROJECTION OF ENTRIES & CROSSCUTS HAVING A MAXIMUM WIDTH OF 20 FEET
STRUCTURE	

NOTE: ANY PROJECTED COAL PILLAR FULLY OR PARTIALLY WITHIN AN AREA DESIGNATED FOR 50% MINING SHALL BE LEFT IN PLACE INTACT



*Alfred Reisz*

**ALLEGHENY No. 2 & PORTAL No. 3 MINE**  
**UPPER FREPORT COAL SEAM**  
**ALLEGHENY COUNTY: FAWN, FRAZER & HARRISON TOWNSHIPS**  
**BUTLER COUNTY: BUFFALO & CLINTON TOWNSHIPS**  
**PENN ALLEGH COAL CO., INC.**  
**ADDRESS: BOX 238A, RD 2, TARENTUM, PA. 15084**

SCALE 1" = 200'      SURVEY DATE: 7/31/72      SHEET No. 17