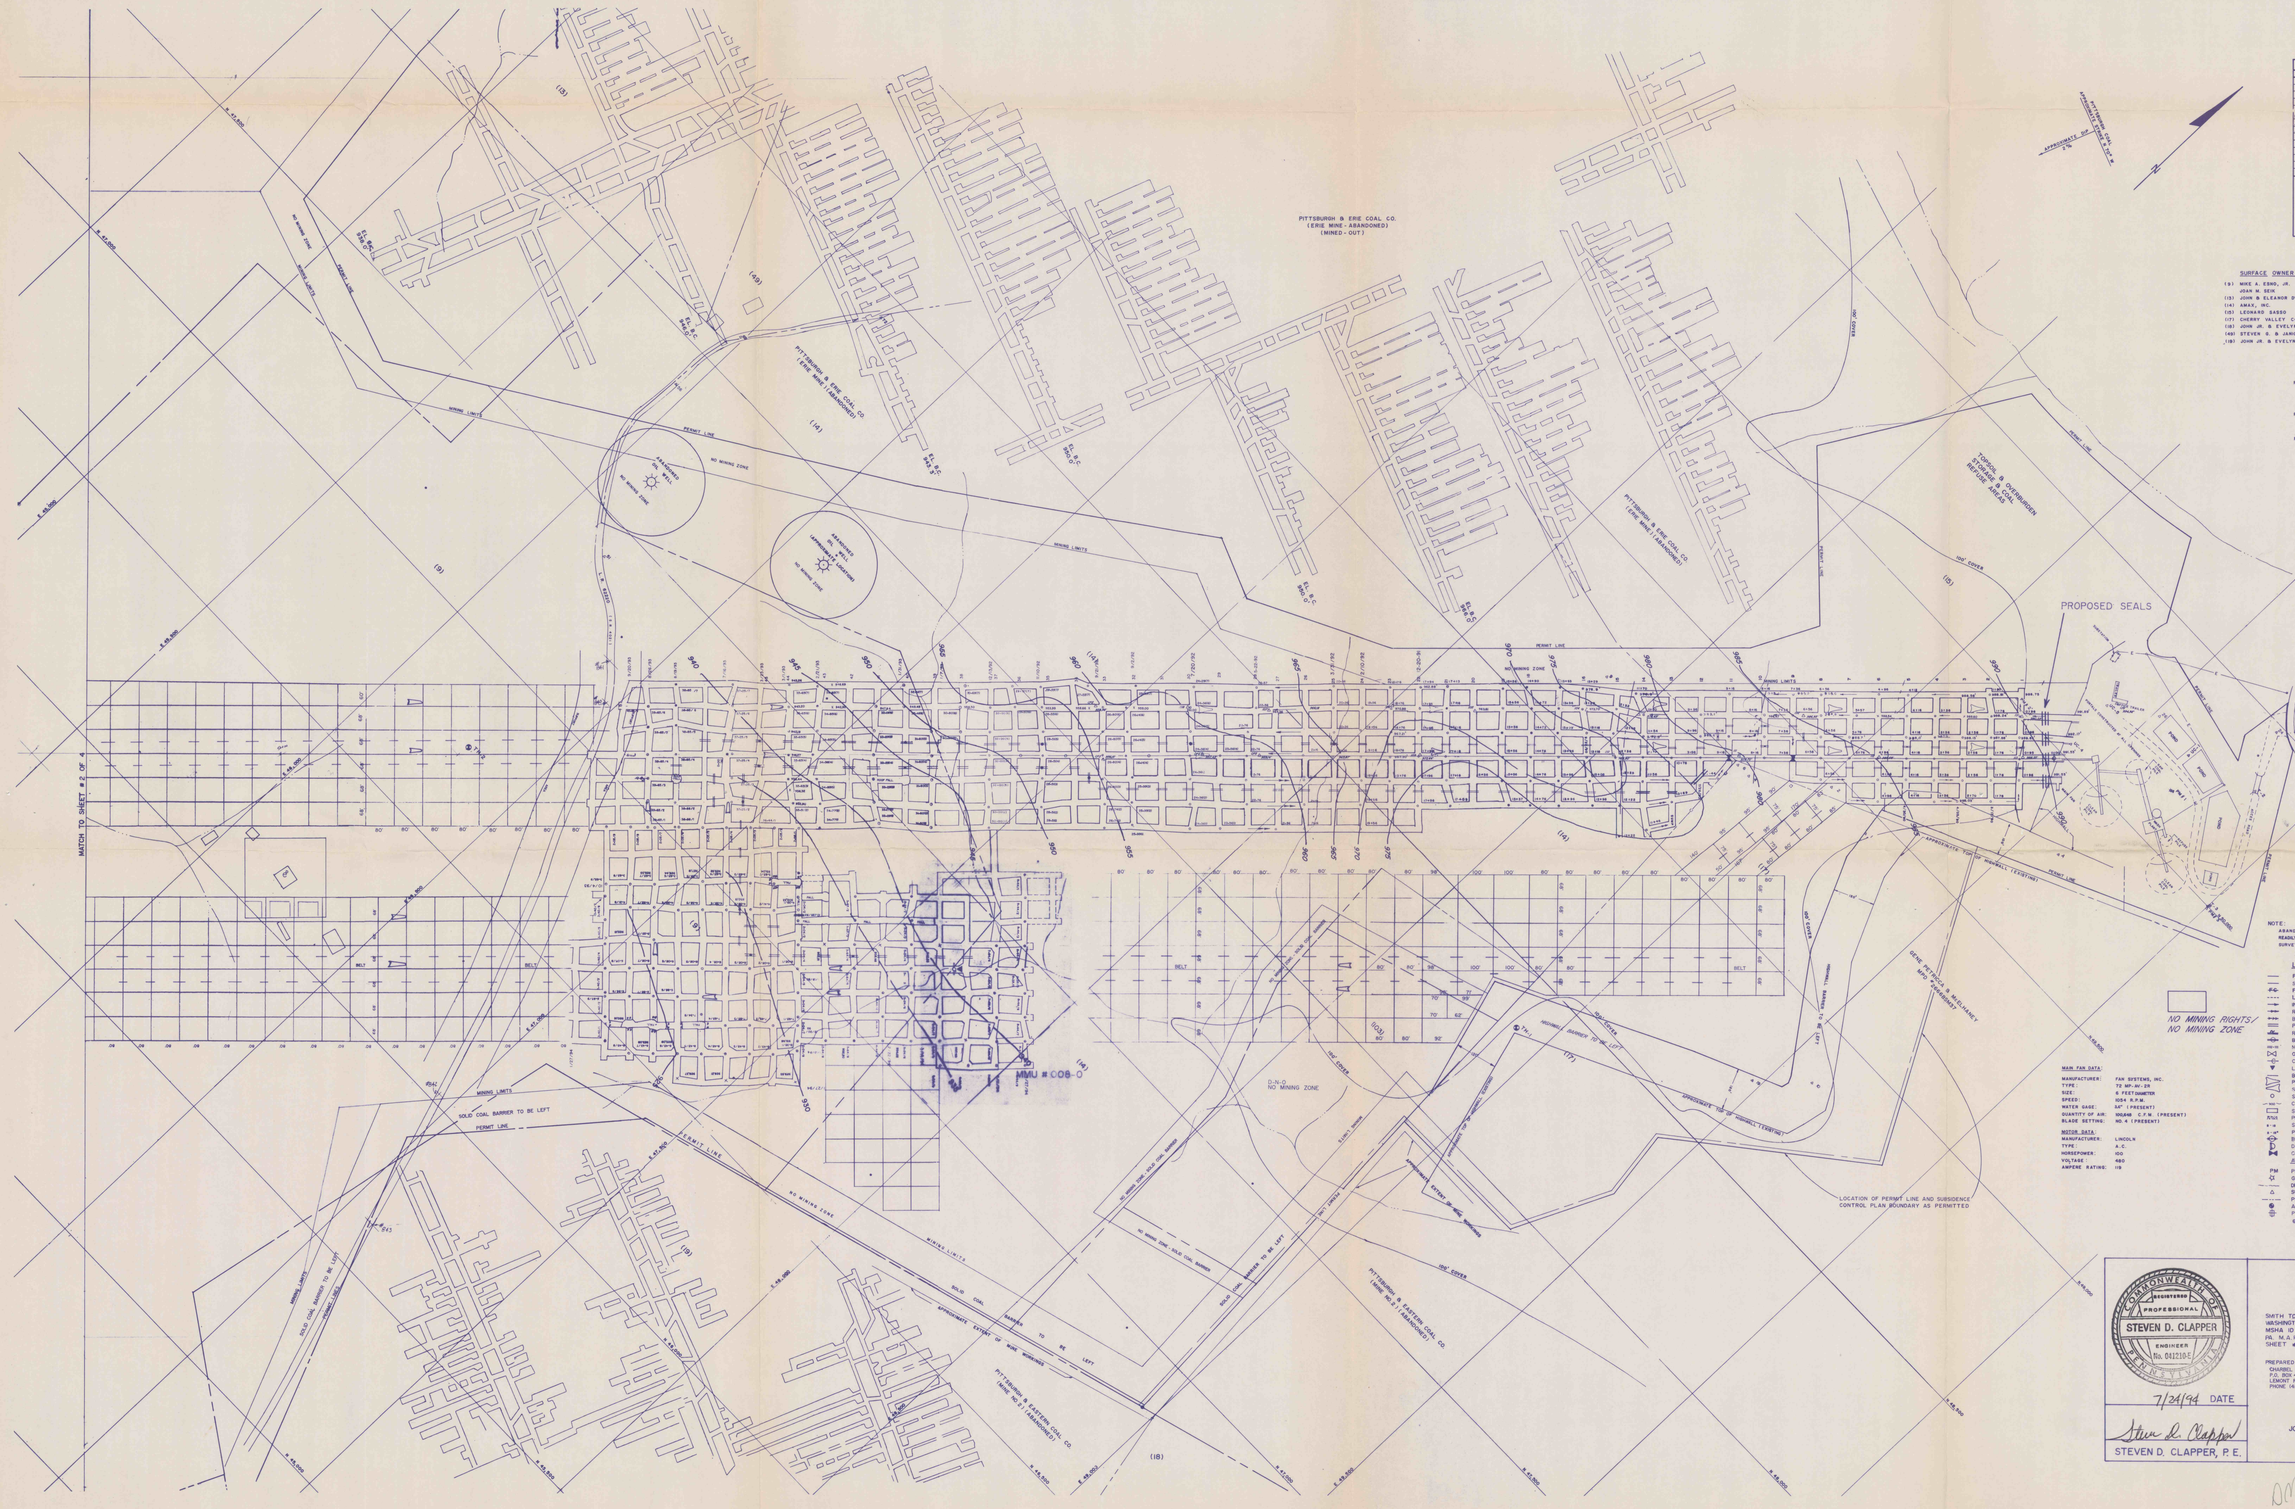

REVISIONS / UPDATES					
BY	BRIEF	DATE	BY	BRIEF	DATE
KLM	PROJECTIONS	9/03/90			
MA	PROJECTIONS	9/22/90			
	UPDATE	9/22/90			
W.L.P.	UPDATE	2/26/92			
RAB	UPDATE	9/8/92			
DJD	UPDATE	10/6/92			
CKE	CONTOURS/SEAM	10/20/92			
P.F.P.	UPDATE	11/10/92			

ENGINEER

SURFACE OWNER

(9) MIKE A. ESNO, JR.
JOAN M. SEIK
(13) JOHN & ELEANOR DVORSAK
(14) AMAX, INC.
(15) LEONARD SASSO
(17) CHERRY VALLEY COAL MINING CO.
(18) JOHN JR. & EVELYN M. VERELST
(49) STEVEN G. & JANICE R. OSTOP
(19) JOHN JR. & EVELYN M. VERELST

MINERAL OWNER

LEONARD SASSO
LEONARD SASSO
LEONARD SASSO
LEONARD SASSO
EUGENE PETRICCA
EUGENE PETRICCA & LEONARD SASSO
LEONARD SASSO
EUGENE PETRICCA & LEONARD SASSO

PM #1
N 50,154.8762
E 49,696.1046
EL. 1,000.21'

PM #2
N 50,015.6855
E 49,205.8501

PM #3
N 49,995.1742
E 50,003.3285
EL. 998.43'

NOTES

(1) THIS MAP SATISFIES THE REQUIREMENTS OF 30 CFR 75.1200 AND 75.372
(2) PERSONS RESPONSIBLE FOR INFORMATION ON THIS MAP: **MAINE ROZAK & STEVE CLAPPER**
(3) SURVEY BY CLOSED LOOP METHOD WITH AN ACCURACY OF AT LEAST 1 IN 5000
(4) NO UNDERLYING OR OVERLYING UNDERGROUND MINING ACTIVITY IS PRESENT
(5) SEE EXHIBIT I FOR ADJACENT PITTSBURGH SEAM DEEP MINES
(6) ALL THREE PERMANENT MONUMENTS ARE CONCRETE MONUMENTS WITH AN IRON PIN
(7) THE CONTINUOUS MINER'S MMU # IS 008-0

NOTE:
ABANDONED MINE WORKINGS AS SHOWN WERE TAKEN FROM READILY AVAILABLE INFORMATION AND DOES NOT DEPICT THE SURVEYED LOCATION, BY CHARBEL ENGINEERING SERVICES, OF SAME

NO MINING RIGHTS/
NO MINING ZONE

LEGEND:

PERMIT LINE
SUBSIDENCE CONTROL BOUNDARY
FRAMED CHECK CURTAIN
LINE CURTAIN
INTAKE
RETURN
BLEEDER
PERMANENT STOPPING
REGULATOR
BOXCHECK
HANDOOR
OVERCAST (PROPOSED)
CHECK CURTAIN
LOADING POINT
BELT
PRIMARY ESCAPEWAY
SECONDARY ESCAPEWAY
SURVEY STATION (UNDERGROUND)
COAL CONTOUR
SUPPORT BLOCK (50 % MINING)
PILLARED AREA
STRUCTURE INVENTORY NUMBER
PRE - 1966 STRUCTURE
BELT OVER TRACK
DOOR
COMPLETED OVERCAST
AVERAGE ENTRY WIDTH - 19' HEIGHT - 16'
PM PERMANENT MONUMENT
GAS OR OIL WELL
DRAIN
SURFACE SURVEY STATION
PROPERTY LINE
APPROXIMATE BOREHOLE LOCATION
PROPOSED BELT TRANSFER
6 MONTH PROJECTION LIMITS

MAIN FAN DATA:

MANUFACTURER:	FAN SYSTEMS, INC.
TYPE:	72 MP-AV-2R
SIZE:	6 FEET DIAMETER
SPEED:	1054 R.P.M.
WATER GAGE:	34" (PRESENT)
QUANTITY OF AIR:	100,848 C.F.M. (PRESENT)
BLADE SETTING:	NO. 4 (PRESENT)

MOTOR DATA:

MANUFACTURER:	LINCOLN
TYPE:	A.C.
HORSEPOWER:	100
VOLTAGE:	480
AMPERE RATING:	119

PITTSBURGH MINING COMPANY
P.O. BOX 47
JOFFRE, PENNSYLVANIA 15053

COMMONWEALTH OF PENNSYLVANIA
REGISTERED PROFESSIONAL
STEVEN D. CLAPPER
ENGINEER
No. 041210-E

7/24/94 DATE

Steven D. Clapper
STEVEN D. CLAPPER, P.E.

PENN BALT #1

FINAL MAP

SMITH TOWNSHIP
WASHINGTON COUNTY
MSHA ID # 36-08028
PA. M.A.I. NUMBER 63871301
SHEET #1 OF 4 SCALE 1" = 200'

PREPARED BY:
CHARBEL ENGINEERING SERVICES
P.O. BOX 44
LEMONT FURNACE, PA 15456
PHONE (412) 439 1313

PERMITTEE:
PENN BALT, INC.
P.O. BOX 287
JOFFRE, PENNSYLVANIA 15053 0287

RECEIVED
JUL 26 1994
Dept. of Environmental Resources
McMurray District Office

DMS