




LION MINING COMPANY


Lion Mining Co.

Jennifer Mine (E seqm)
 Permit No. 56841306
 Jenner Township
 Somerset Co.

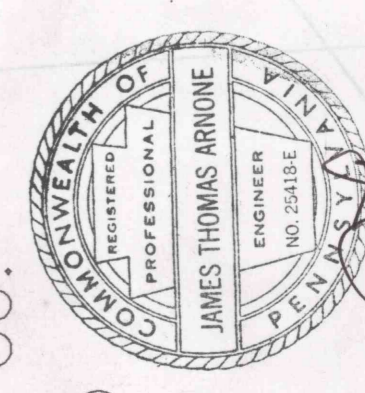

 9 Dec 88

FINAL MAP
 Scale 1"=200'
 LEGEND
 Permit Line
 Surface Road
 Stream
 Structure
 50% Mining

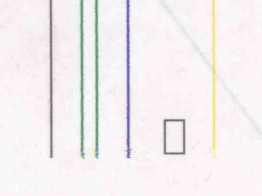

27"x41"