


**REVISION**  
 10/1/86  
**FEB 7**  
 7/2/96  
 TO PREVIOUS SUBMITTAL

**LEGEND**

<p>PERMIT AREA</p> <p>UNDERGROUND WORKINGS</p> <p>TOWNSHIP BOUNDARY</p> <p>COUNTY BOUNDARY</p> <p>TEST BOREHOLE</p> <p>CROP LINES</p> <p>COAL CONTOURS</p> <p>SURFACE WORKINGS</p> <p>MINE OPENINGS, Not Sealed</p> <p>MINE OPENINGS, Sealed</p> <p>PROPERTY LINES</p> <p>PRE 1966 DWELLINGS</p>	<p>POST 1966 DWELLINGS</p> <p>CEMETERIES</p> <p>STRUCTURES</p> <p>MAJOR ELECTRIC LINES</p> <p>PIPELINES</p> <p>GAS WELLS</p> <p>WATER WELLS</p> <p>STREAMS</p> <p>LAKES or PONDS</p> <p>SPRING</p> <p>WATER TREATMENT FACILITIES</p> <p>CONTIGUOUS PROPERTY</p>
--	---

**LEGEND cont.**

<p>WATER</p> <p>6 MONTH PROJECTIONS</p> <p>SUPPORT AREA (NO SECOND MINING)</p> <p>CONTEMPLATED MINING</p> <p>COMPLETED MINING</p> <p>SURVEY STATION</p> <p>GAS WELL BARRIER</p>	<p>NO SECOND MINING</p> <p>9/24/91 TO 3/24/92</p> <p>APPROVED</p> <p>APPROVED</p> <p>APPROVED</p> <p>APPROVED</p> <p>APPROVED</p> <p>APPROVED</p>
---	---

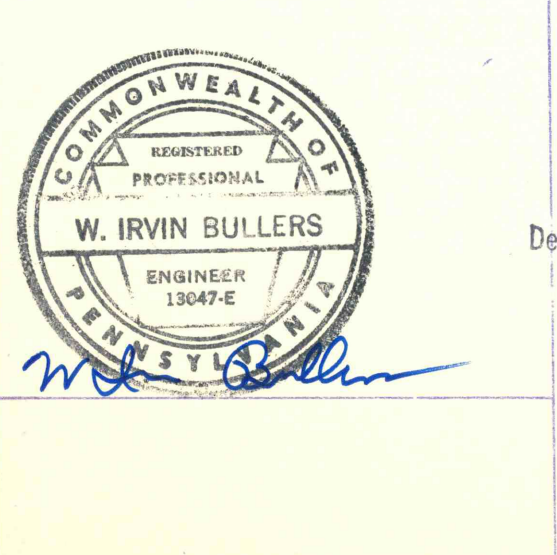

**RECEIVED**  
 FEB 10 1992  
 Dept. of Environmental Resources  
 McMurray District Office



**DOVERSPIKE BROS. COAL CO.**  
 SUGARCAMP No. 2 MINE  
 SCALE: 1"=200'

<p>INTAKE AIR</p> <p>RETURN AIR</p> <p>PRIMARY ESCAPEWAY</p> <p>SECONDARY ESCAPEWAY</p> <p>BELT LINE</p> <p>B-E POINTS (Approved)</p> <p>B-E POINTS (Proposed)</p> <p>STOPPING</p>	<p>STOPPING W/ DOOR</p> <p>CHECK CURTAIN</p> <p>REGULATOR</p> <p>DOUBLE DOORS (Equip. doors)</p> <p>OVERCAST</p>
--	--