


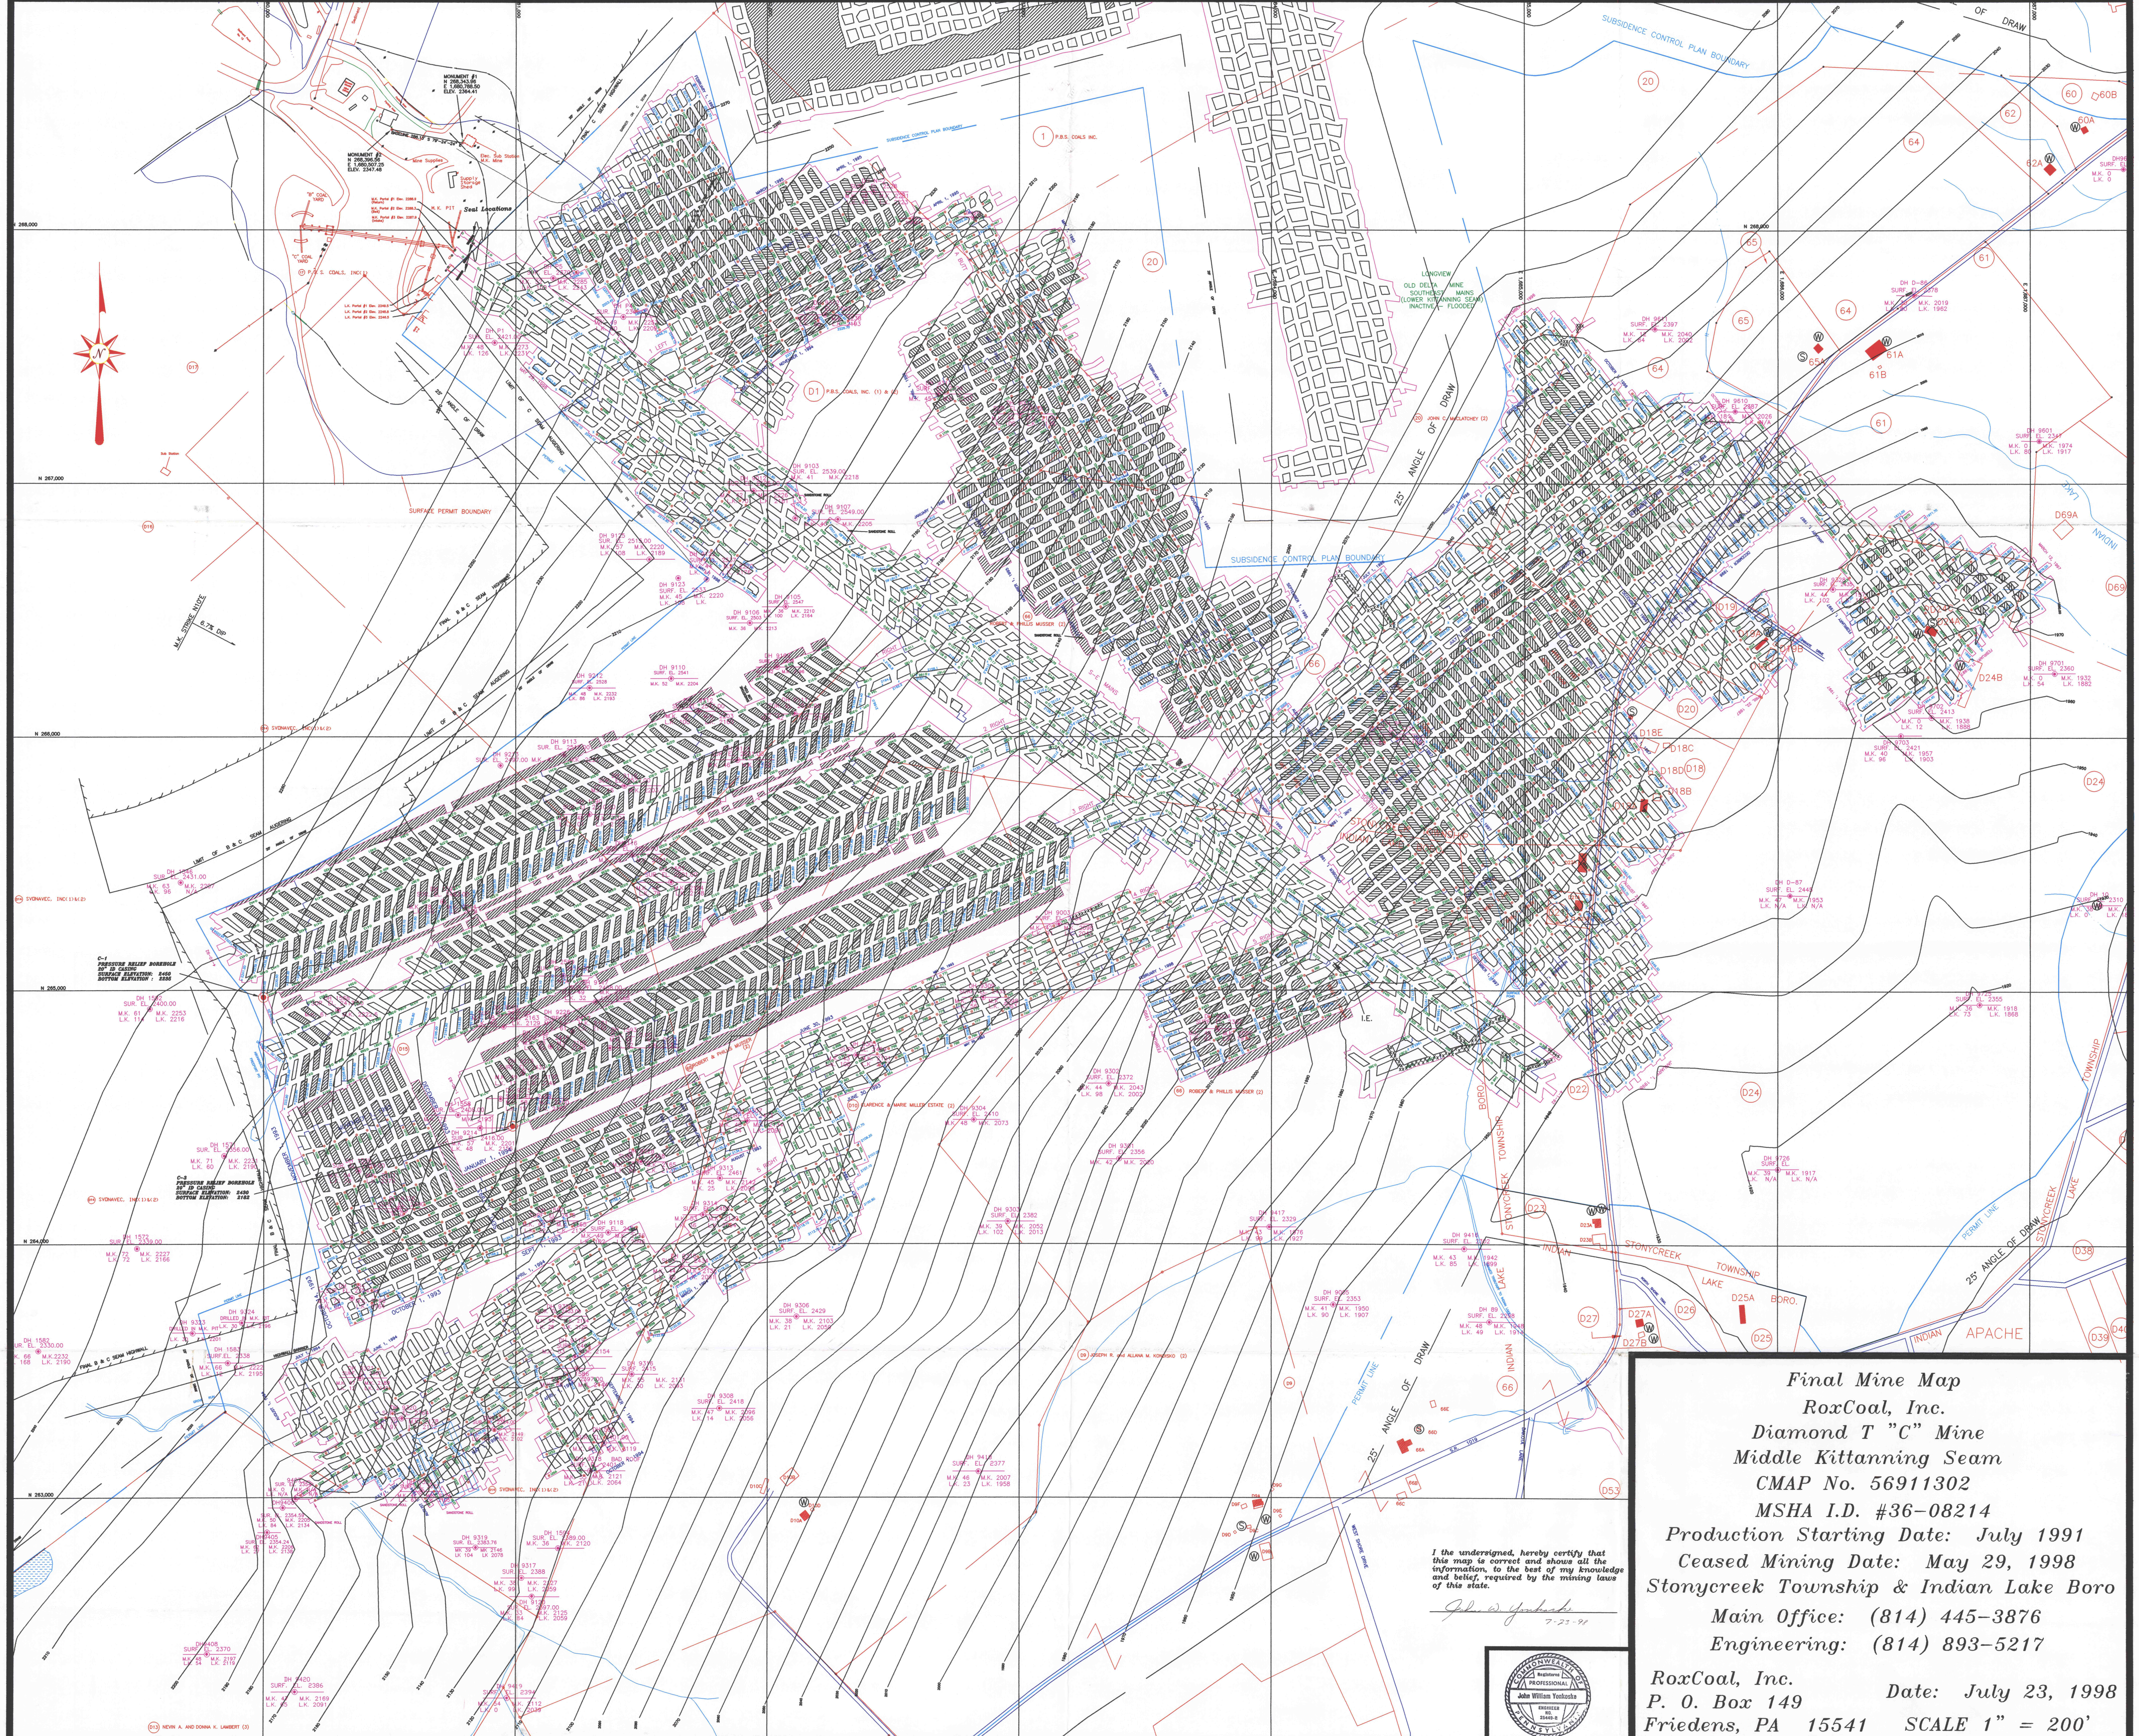

Final Mine Map
RoxCoal, Inc.
Diamond T "C" Mine
Middle Kittanning Seam
CMAF No. 56911302
MSHA I.D. #36-08214
Production Starting Date: July 1991
Ceased Mining Date: May 29, 1998
Stonycreek Township & Indian Lake Boro
Main Office: (814) 445-3876
Engineering: (814) 893-5217

RoxCoal, Inc.
P. O. Box 149
Friedens, PA 15541

Date: July 23, 1998
SCALE 1" = 200'

I the undersigned, hereby certify that
this map is correct and shows all the
information, to the best of my knowledge
and belief, required by the mining laws
of this state.

John W. Yoshida
7-23-98

