

GOB

GOB

KLIPPOCK CREEK

1-65 H

SLABSPRACE COVERED PAV. SIDEWALK

PERMIT (CROSSING) BOUNDARY

0508-109
0508-107

0508-108
0508-107

0508-105

6RF-21471-3

6RF-21471-5

MIXED 3-1-5-85
7-9-15-85


DDH 5-R
SUPE 188.8
CONC 574.7

DDH 1-X
SUPE 1018.3
CONC 574.9

9 ROAD 3 LEFT

9 ROAD 6 LEFT

MIXED 3-1-5-85
7-9-15-85

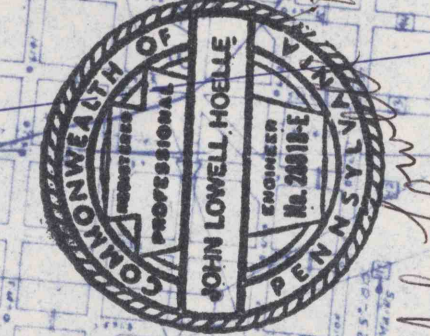

MONONGAHELA RIVER

MINING LIMIT - PERMIT (PROPERTY) BOUNDARY

DDH 6-P
SUPE
CONC

1000'